

TOWN PL	ANNING SHEET INDEX
NO.	SHEET NAME
TP001	COVER SHEET
TP002	NEIGHBOURHOOD & SITE DESCRIPTION
TP003	STREETSCAPE ANALYSIS
TP004	DESIGN RESPONSE
TP005	PERSPECTIVE VIEWS
TP101	EXISTING CONDITIONS PLAN
TP102	DEMOLITION PLAN
TP103	BASEMENT LEVEL
TP104	GROUND LEVEL
TP105	LEVEL 1
TP106	LEVEL 2
TP107	ROOF LEVEL
TP201	ELEVATIONS - SHEET 01
TP202	ELEVATIONS - SHEET 02
TP203	SECTIONS - SHEET 01
TP204	SECTIONS - SHEET 02
TP501	EXTERNAL WORKS
TP601	SHADOW DIAGRAMS 01
TP602	SHADOW DIAGRAMS 02
TP603	SHADOW DIAGRAMS 03
TP604	SHADOW DIAGRAMS 04
TP605	SHADOW DIAGRAMS 05
TP606	SHADOW DIAGRAMS 06
TP607	SHADOW DIAGRAMS 07
TP701	SCREEN DETAILS
TP702	EXTERNAL FINISHES
TP801	URBAN CONTEXT PLAN

ISSUE	REASON FOR ISSUE	DATE
TP01	ISSUE FOR PLANNING APPROVAL	08.12.2016
TFR022	RESTECTUSE FLA CIANUCCAPRILOVAL	10.03.2017
TP03	ISSUE FOR COMPULSORY CONFERENCE	23.04.2018
TP04	CHANGES AGREED AT COMPULSORY CONFERENCE	10.05.2018

ISSUE	REASON FOR ISSUE	DATE	ISSUE	reason f

ISSUE	REASON FOR ISSUE	DATE

COPYRIGHT OF THIS DRAWING AND THE DESIGN DESCRIBED HEREIN IS VESTED IN CAISSON DESIGN GROUP PTY LTD

BEFORE COMMENCING ANY WORK CONTRACTORS MUST VERIFY ALL DIMENSIONS AND LEVELS ON THE SITE AND SUBMIT ALL SHOP DRAWINGS AND COST VARIATIONS TO THE ARCHITECT FOR THEIR WRITTEN APPROVAL ARCHITECTURE CAISSON

CAISSON DESIGN GROUP PTY LTD TRADING AS ARCHITECTURE CAISSON SUITE 3 14 WALLACE AVE TOORAK VICTORIA 3142 AUSTRALIA ABN 56 607 067 925 ACN 607 067 925 PH +61 3 9988 1919

WWW.CAISSON.COM.AU

PROJECT CARINISH ROAD APARTMENTS

**ADDRESS** 179 CARINISH ROAD, CLAYTON VIC COVER SHEET DWG NO.


AZ/CB/JW 10.03.2017

WITHOUT PREJUDICE

PROJECT NO.

16018

SCALE

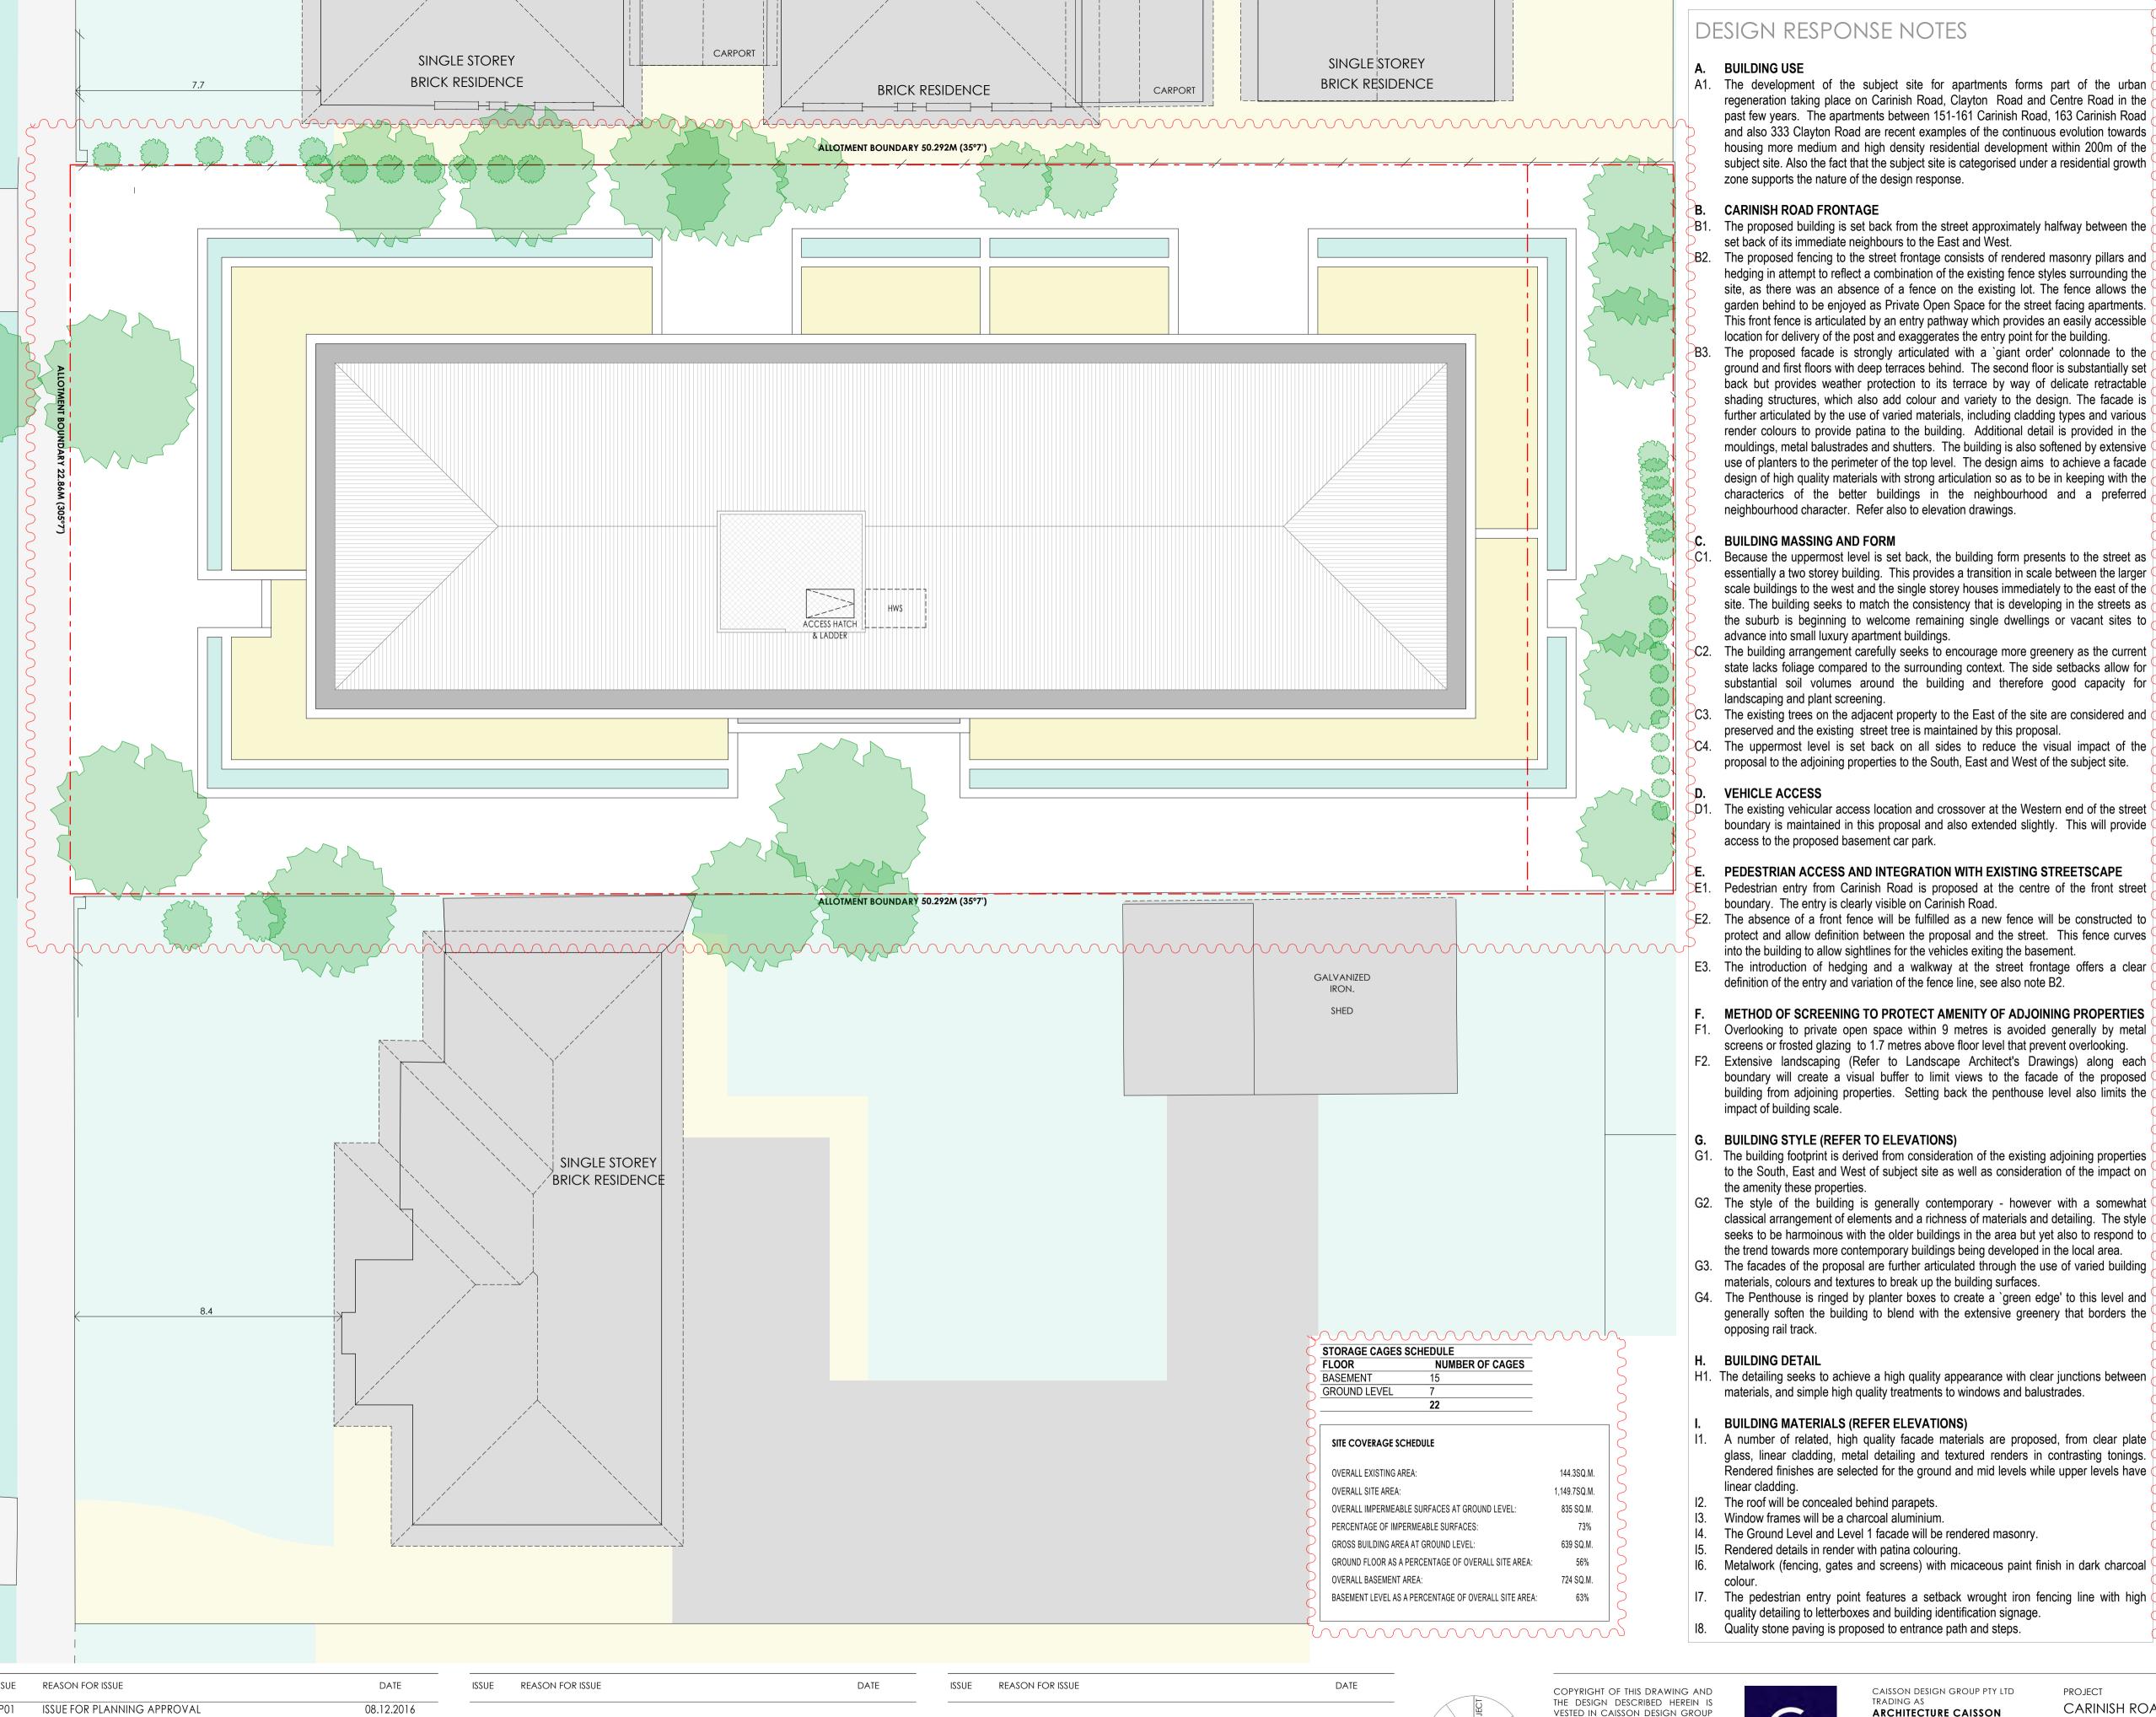

# DESIGN RESPONSE NOTES

### A. BUILDING USE

A1. The development of the subject site for apartments forms part of the urban regeneration taking place on Carinish Road, Clayton Road and Centre Road in the past few years. The apartments between 151-161 Carinish Road, 163 Carinish Road and also 333 Clayton Road are recent examples of the continuous evolution towards housing more medium and high density residential development within 200m of the subject site. Also the fact that the subject site is categorised under a residential growth zone supports the nature of the design response.

#### CARINISH ROAD FRONTAGE

- B1. The proposed building is set back from the street approximately halfway between the set back of its immediate neighbours to the East and West.
- B2. The proposed fencing to the street frontage consists of rendered masonry pillars and hedging in attempt to reflect a combination of the existing fence styles surrounding the site, as there was an absence of a fence on the existing lot. The fence allows the garden behind to be enjoyed as Private Open Space for the street facing apartments. This front fence is articulated by an entry pathway which provides an easily accessible location for delivery of the post and exaggerates the entry point for the building.
- graphsB3. The proposed facade is strongly articulated with a 'giant order' colonnade to the ground and first floors with deep terraces behind. The second floor is substantially set back but provides weather protection to its terrace by way of delicate retractable shading structures, which also add colour and variety to the design. The facade is further articulated by the use of varied materials, including cladding types and various render colours to provide patina to the building. Additional detail is provided in the mouldings, metal balustrades and shutters. The building is also softened by extensive use of planters to the perimeter of the top level. The design aims to achieve a facade design of high quality materials with strong articulation so as to be in keeping with the characterics of the better buildings in the neighbourhood and a preferred neighbourhood character. Refer also to elevation drawings.

#### C. BUILDING MASSING AND FORM

C1. Because the uppermost level is set back, the building form presents to the street as essentially a two storey building. This provides a transition in scale between the larger scale buildings to the west and the single storey houses immediately to the east of the site. The building seeks to match the consistency that is developing in the streets as the suburb is beginning to welcome remaining single dwellings or vacant sites to advance into small luxury apartment buildings.

C2. The building arrangement carefully seeks to encourage more greenery as the current state lacks foliage compared to the surrounding context. The side setbacks allow for substantial soil volumes around the building and therefore good capacity for landscaping and plant screening.

C3. The existing trees on the adjacent property to the East of the site are considered and preserved and the existing street tree is maintained by this proposal.

C4. The uppermost level is set back on all sides to reduce the visual impact of the proposal to the adjoining properties to the South, East and West of the subject site.

#### D. VEHICLE ACCESS

D1. The existing vehicular access location and crossover at the Western end of the street boundary is maintained in this proposal and also extended slightly. This will provide access to the proposed basement car park.

# PEDESTRIAN ACCESS AND INTEGRATION WITH EXISTING STREETSCAPE

Pedestrian entry from Carinish Road is proposed at the centre of the front street boundary. The entry is clearly visible on Carinish Road. E2. The absence of a front fence will be fulfilled as a new fence will be constructed to

protect and allow definition between the proposal and the street. This fence curves into the building to allow sightlines for the vehicles exiting the basement. E3. The introduction of hedging and a walkway at the street frontage offers a clear

F. METHOD OF SCREENING TO PROTECT AMENITY OF ADJOINING PROPERTIES

F1. Overlooking to private open space within 9 metres is avoided generally by metal LEVEL 1

screens or frosted glazing to 1.7 metres above floor level that prevent overlooking. F2. Extensive landscaping (Refer to Landscape Architect's Drawings) along each boundary will create a visual buffer to limit views to the facade of the proposed building from adjoining properties. Setting back the penthouse level also limits the impact of building scale.

## G. BUILDING STYLE (REFER TO ELEVATIONS)

G1. The building footprint is derived from consideration of the existing adjoining properties to the South, East and West of subject site as well as consideration of the impact on the amenity these properties.

G2. The style of the building is generally contemporary - however with a somewhat classical arrangement of elements and a richness of materials and detailing. The style seeks to be harmoinous with the older buildings in the area but yet also to respond to the trend towards more contemporary buildings being developed in the local area.

materials, colours and textures to break up the building surfaces. G4. The Penthouse is ringed by planter boxes to create a 'green edge' to this level and ' generally soften the building to blend with the extensive greenery that borders the

# H. BUILDING DETAIL

H1. The detailing seeks to achieve a high quality appearance with clear junctions between materials, and simple high quality treatments to windows and balustrades.

## **BUILDING MATERIALS (REFER ELEVATIONS)**

11. A number of related, high quality facade materials are proposed, from clear plate BASEMENT glass, linear cladding, metal detailing and textured renders in contrasting tonings. Rendered finishes are selected for the ground and mid levels while upper levels have linear cladding.

## 12. The roof will be concealed behind parapets.

Window frames will be a charcoal aluminium.

14. The Ground Level and Level 1 facade will be rendered masonry.

Rendered details in render with patina colouring.

16. Metalwork (fencing, gates and screens) with micaceous paint finish in dark charcoal 17. The pedestrian entry point features a setback wrought iron fencing line with high

quality detailing to letterboxes and building identification signage. 18. Quality stone paving is proposed to entrance path and steps.

<b>GROSS AREA SCHEDUL</b>	E (EXCL. TERRAC	<b>E</b> )			$\circ$
FLOOR	ZONE NAME	0 0	0 0	MEASURED	AREA
BASEMENT					
	GROSS BASEMEI	NT AREA	4	687	
GROUND LEVEL					
	GROSS BUILDING	3 AREA		638	
LEVEL 1	_				
	GROSS BUILDING	3 AREA		643	-
LEVEL 2					
	GROSS BUILDING	3 AREA		446	
ROOF LEVEL					
	ROOF AREA			437	
				2,851 m <sup>2</sup>	
APARTMENT SALEABLE	AREA SUMMARY	(EXCL.	TERRA	CE)	_
FLOOR	ZONE NAME	QTY		URED AREA	_
<b>GROUND LEVEL</b>					_
	1 BED	2	104		_
	2 BED + STUDY	6	443		_
LEVEL 1					_
	2 BED	3	253		_
	2 BED + STUDY	4	310		_
LEVEL 2					_
	1 BED	1	58		_
	2 BED	4	327		_

20 1,495 m<sup>2</sup>

COURTYARD & TER	RACE SUMMARY			
FLOOR	ZONE NAME	<b>MEASURED AREA</b>		
GROUND LEVEL				
	P.O.S	362		
	PERMEABLE AREA	315		
	PLANTER	7		
	TERRACE	95		
LEVEL 1				
	BALCONY	91		
	PLANTER	12		
LEVEL 2				
	BALCONY	290		
		1,172 m <sup>2</sup>		

ZONE NAME

**GROUND LEVEL AREAS** 

EMENT LEVEL AREAS				
)R	ZONE NAME	<b>MEASURED AREA</b>		
<b>EMENT</b>				
	BIKE	8		
	GROSS BASEMENT AREA (INCL. RAMP)	724		
	LIFT	4		
	PERMEABLE AREA	426		
	RESIDENT	289		
	SITE AREA	1,150		
	SRVCS	2		
	STAIRS	11		

MEASURED AREA

<b>GROUND LEVEL</b>		
	1 BED	104
	2 BED + STUDY	443
	CORRIDOR	64
	LIFT	4
	P.O.S	362
	PERMEABLE AREA	315
	PLANTER	7
	RISER	1
	SERVICES	11
	SHED	14
	SRVCS	1
	STAIRS	11
	TERRACE	95
LEVEL 1 AREAS		

	ILITIVIOL	00
1 AREAS		
	<b>ZONE NAME</b>	<b>MEASURED AREA</b>
. 1		
	2 BED	253
	2 BED + STUDY	310
	BALCONY	91
	CORRIDOR	52
	LIFT	8
	PLANTER	12
	SRVCS	1
	STAIRS	22
		749 m <sup>2</sup>

LEVEL 2 AREAS		
FLOOR	ZONE NAME	MEASURED AREA
LEVEL 2	'	
	1 BED	58
	2 BED	327
	BALCONY	290
	CORRIDOR	26
	LIFT	8
	SRVCS	2
	STAIRS	22
	,	733 m <sup>2</sup>
CARPARKING S	CHEDULE	
FLOOR	NO.	CATEGORY

	16	CARSPACE (	CAR STACKER
	25		
YCLE STORAGE	SCHEDULE		
OOR	NUMB	ER OF BIKES	
SEMENT			
		8	
		_	

4 CARSPACE VISITOR

5 CARSPACE RESIDENT

 $\cdots \cdots$ WITHOUT PREJUDICE

PROJECT NO.

16018

TP01	ISSUE FOR PLANNING APPROVAL	08.12.2016
TP02	RESPONSE TO COUNCIL RFI	14.03.2017
TP03	ISSUE FOR COMPULSORY CONFERENCE	23.04.2018
TP04	CHANGES AGREED AT COMPULSORY CONFERENCE	10.05.2018

VESTED IN CAISSON DESIGN GROUP PTY LTD

BEFORE COMMENCING ANY WORK CONTRACTORS MUST VERIFY ALL DIMENSIONS AND LEVELS ON THE SITE AND SUBMIT ALL SHOP DRAWINGS AND COST VARIATIONS TO THE ARCHITECT FOR THEIR WRITTEN APPROVAL



CAISSON DESIGN GROUP PTY LTD trading as ARCHITECTURE CAISSON 14 WALLACE AVE TOORAK VICTORIA 3142 AUSTRALIA

ABN 56 607 067 925 PH +61 3 9988 1919

WWW.CAISSON.COM.AU


CARINISH ROAD APARTMENTS **ADDRESS** 

DWG NO.

TP004

179 CARINISH ROAD, CLAYTON VIC **DWG TITLE** 


DESIGN RESPONSE **SCALE** REVISION TP04 AZ/CB/JW 10.05.2018 1:100 @A1

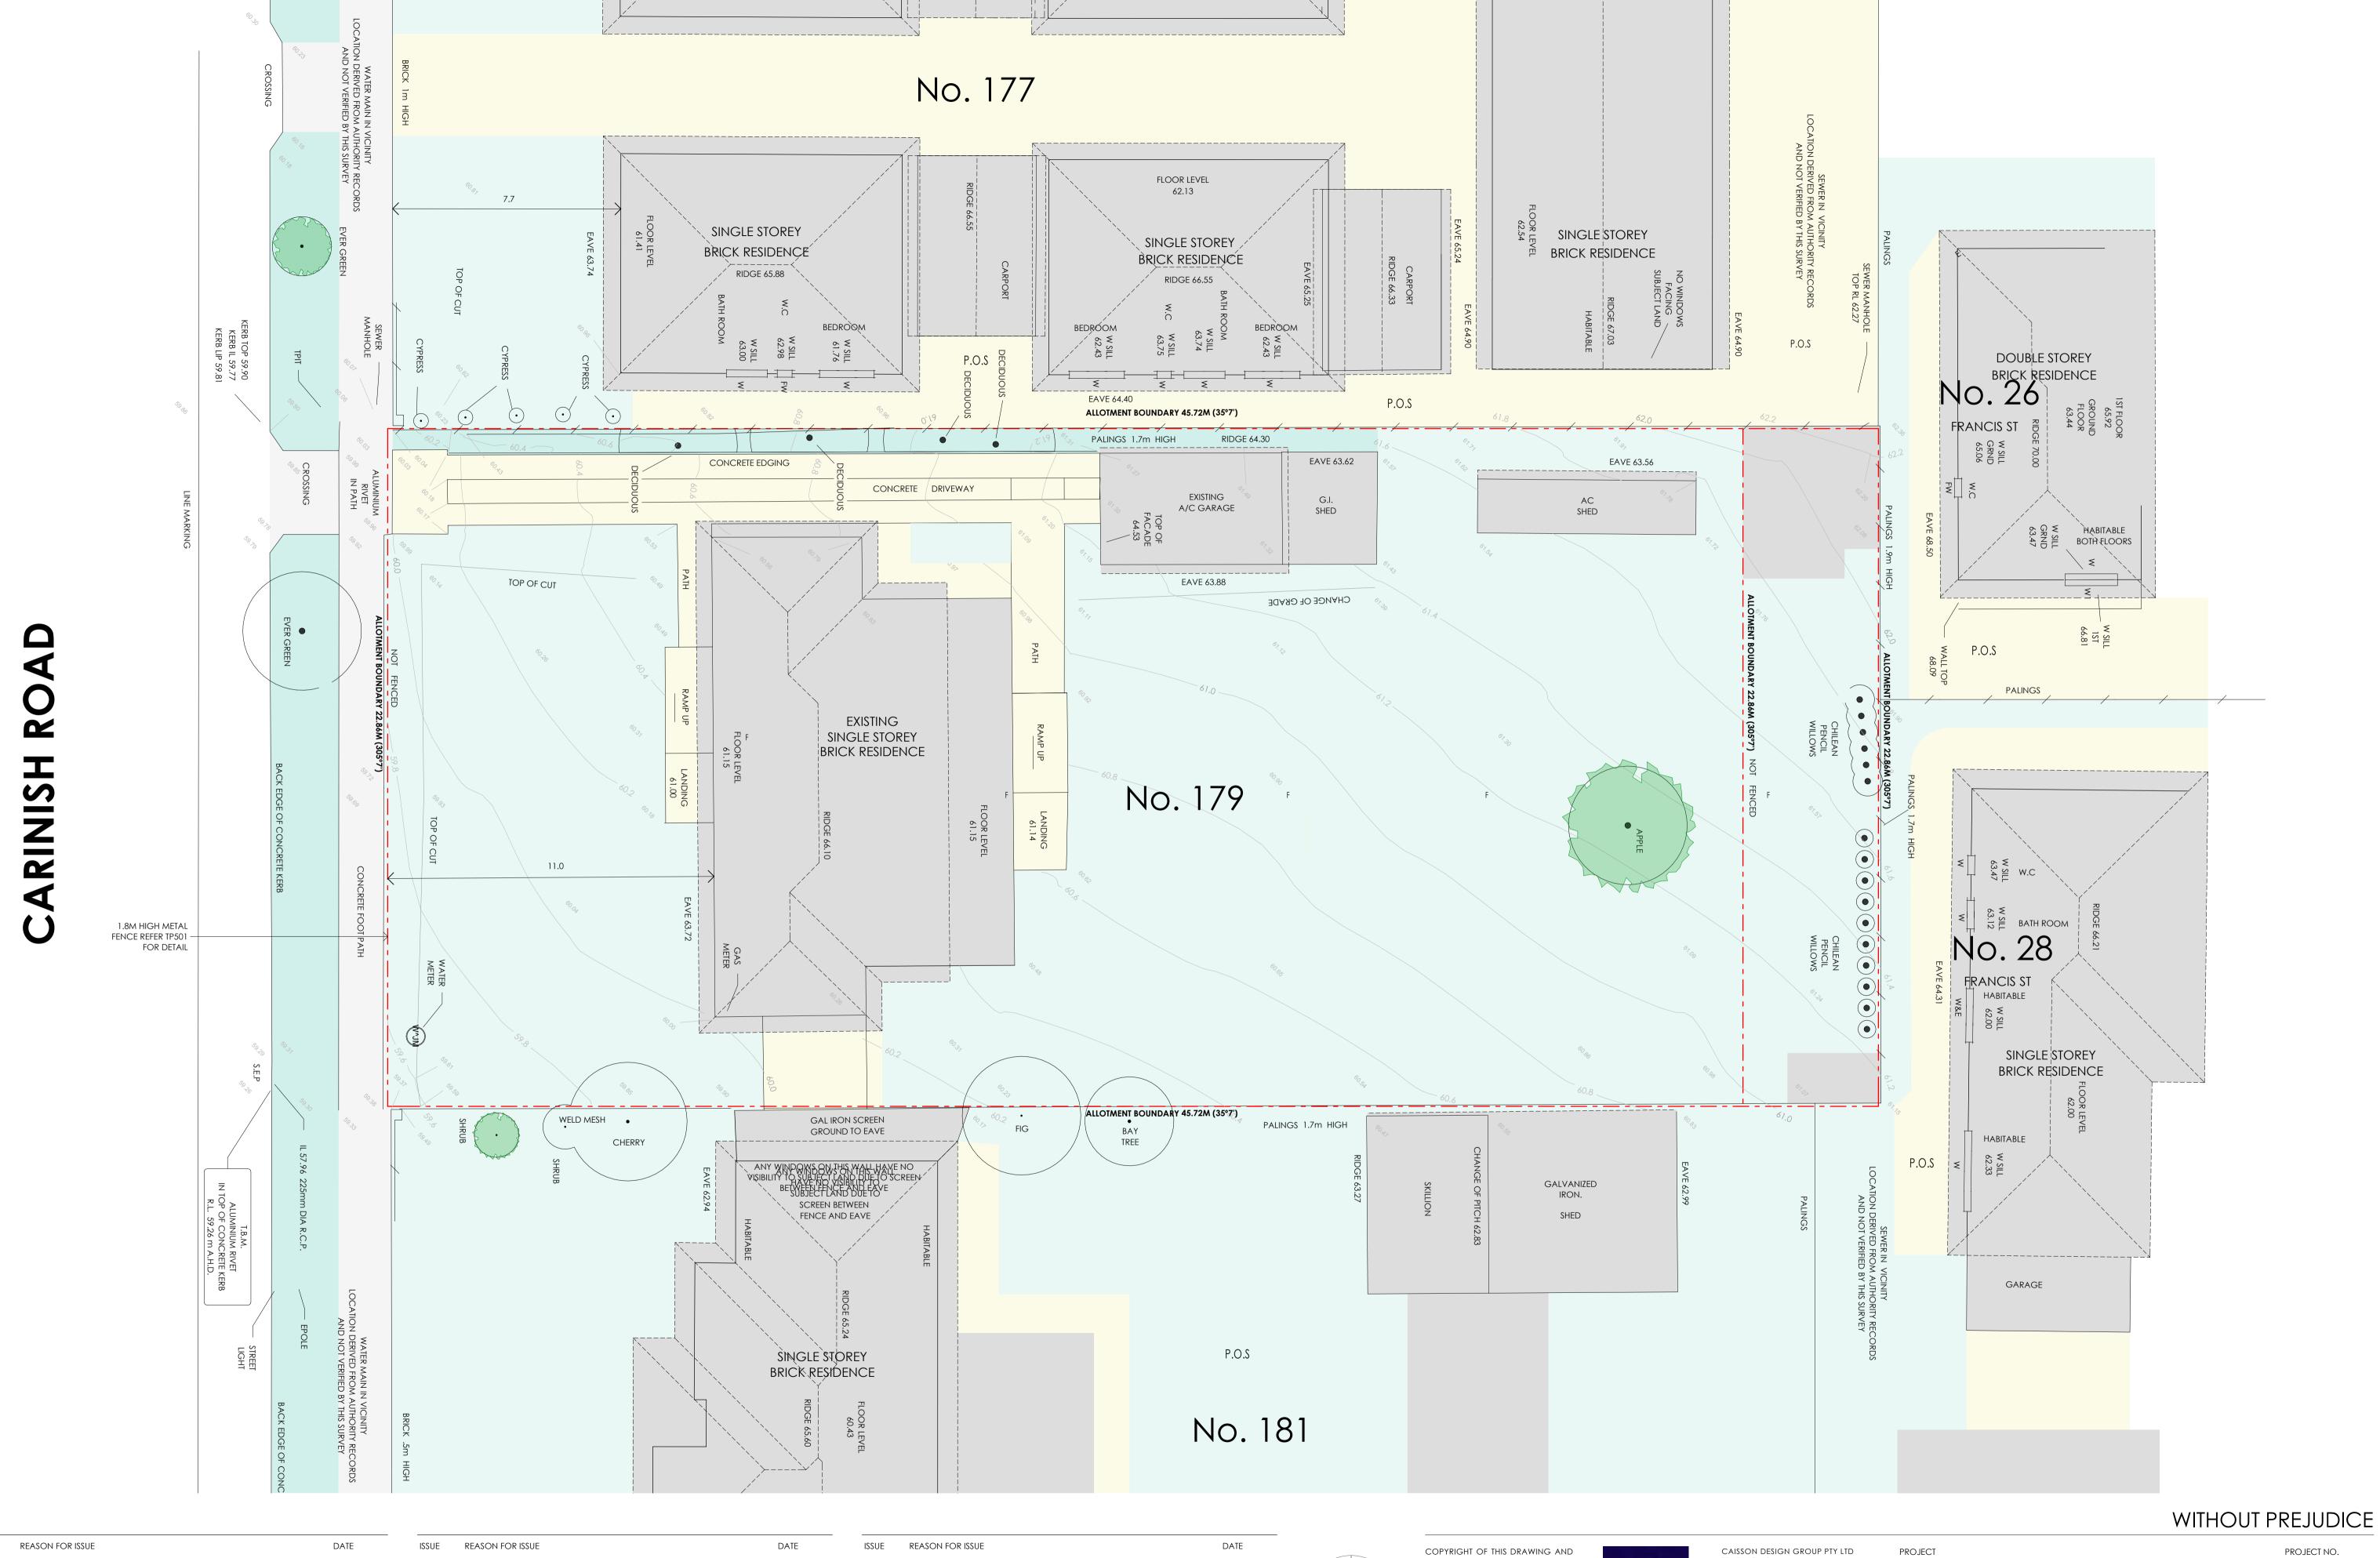

ISSUE	REASON FOR ISSUE	DATE
TP01	ISSUE FOR PLANNING APPROVAL	08.12.2016
TP02	RESPONSE TO COUNCIL RFI	14.03.2017
TP03	ISSUE FOR COMPULSORY CONFERENCE	23.04.2018
TP04	CHANGES AGREED AT COMPULSORY CONFERENCE	10.05.2018

SSUE	REASON FOR ISSUE	DATE	ISS

ISSUE	REASON FOR ISSUE	DATE

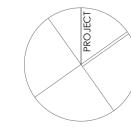

COPYRIGHT OF THIS DRAWING AND THE DESIGN DESCRIBED HEREIN IS VESTED IN CAISSON DESIGN GROUP PTY LTD

BEFORE COMMENCING ANY WORK
CONTRACTORS MUST VERIFY ALL
DIMENSIONS AND LEVELS ON THE
SITE AND SUBMIT ALL SHOP
DRAWINGS AND COST VARIATIONS
TO THE ARCHITECT FOR THEIR
WRITTEN APPROVAL

ARCHITECT
CAISS

<del>-</del> O-	
ARCHITECTURE GAISSON	

CAISSON DESIGN GROUP PTY LTD TRADING AS

ARCHITECTURE CAISSON

SUITE 3
14 WALLACE AVE TOORAK
VICTORIA 3142 AUSTRALIA

ABN 56 607 067 925
ACN 607 067 925
PH +61 3 9988 1919

WWW.CAISSON.COM.AU

PROJECT
CARINISH ROAD APARTMENTS
ADDRESS
179 CARINISH ROAD, CLAYTON VIC


TP04

ADDRESS
179 CARINISH ROAD, CLAYTON VIC
DWG TITLE
EXISTING CONDITIONS PLAN
DWG NO. REVISION DRAWN

TP101

DRAWN DATE SCALE
AZ/CB/JW 10.05.2018 1:100 @A1

16018

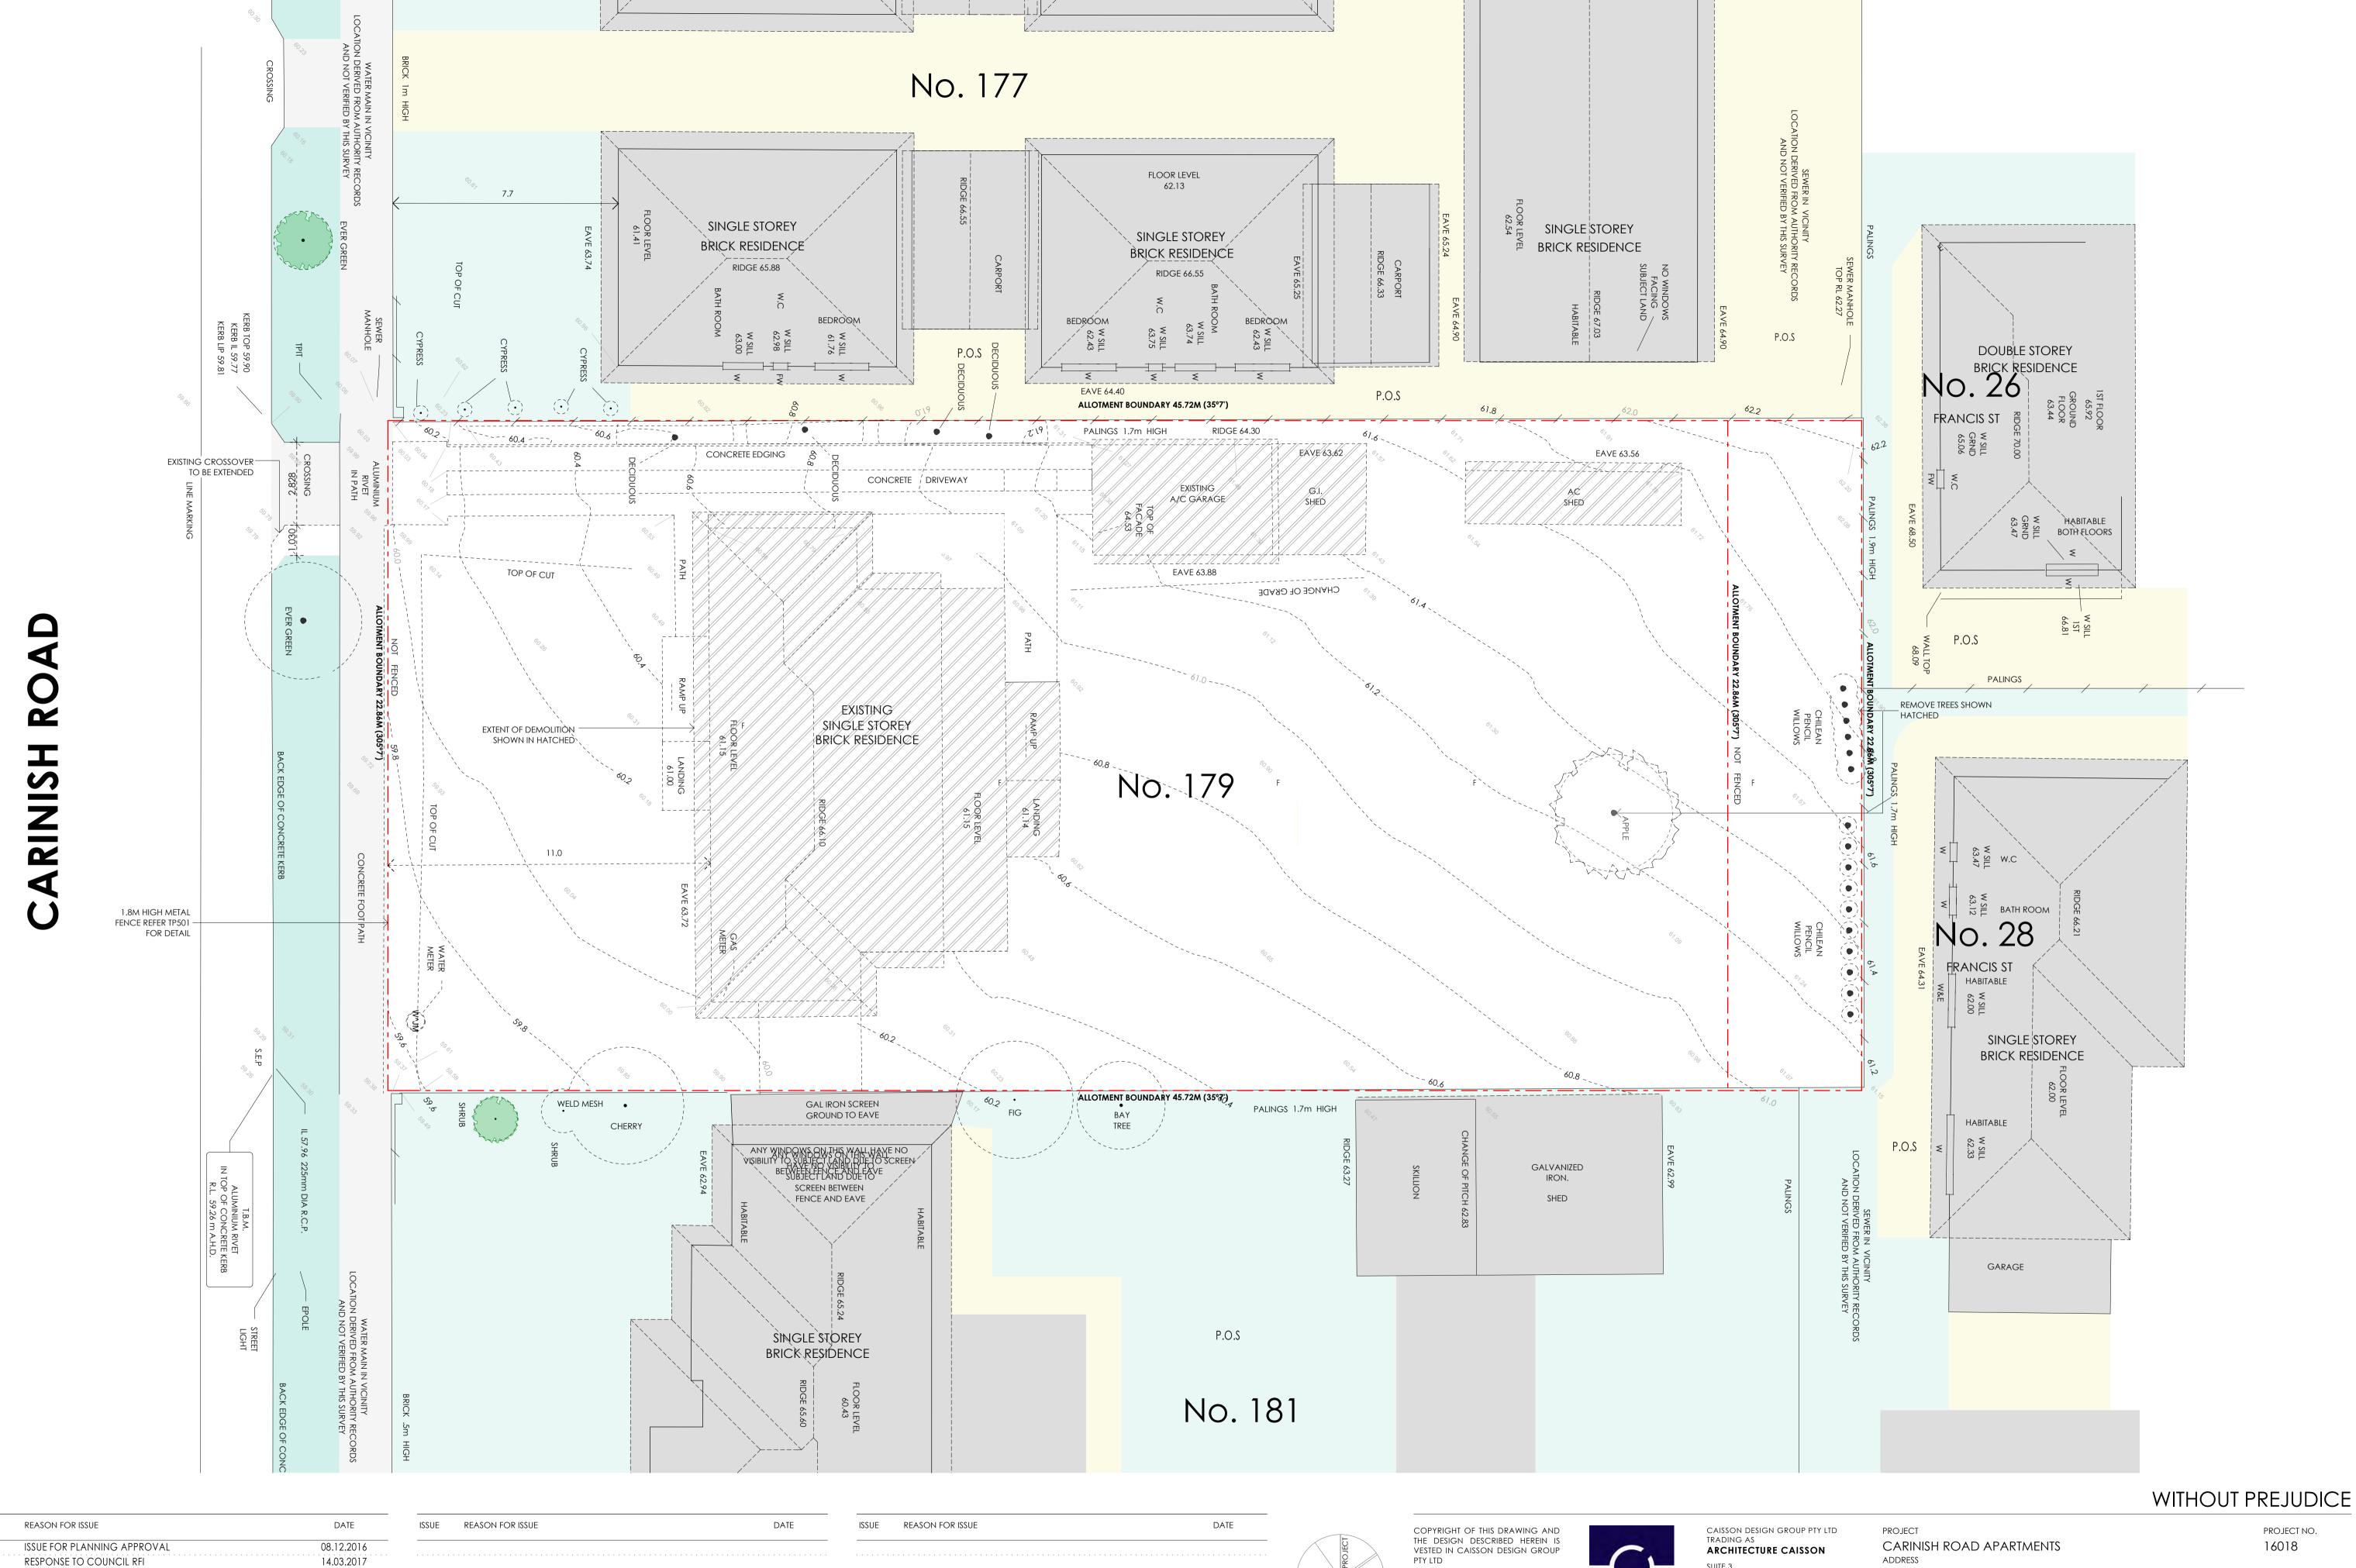


23.04.2018

10.05.2018

ISSUE FOR COMPULSORY CONFERENCE

TP04 CHANGES AGREED AT COMPULSORY CONFERENCE

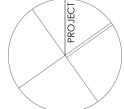



DRAWINGS AND COST VARIATIONS

TO THE ARCHITECT FOR THEIR WRITTEN APPROVAL

ARCHITECTURE GAISSON WWW.CAISSON.COM.AU

SUITE 3 14 WALLACE AVE TOORAK VICTORIA 3142 AUSTRALIA ABN 56 607 067 925 ACN 607 067 925 PH +61 3 9988 1919

179 CARINISH ROAD, CLAYTON VIC **DWG TITLE** 


DWG NO.

DEMOLITION PLAN DATE DRAWN

AZ/CB/JW

SCALE

10.05.2018 1:100 @A1

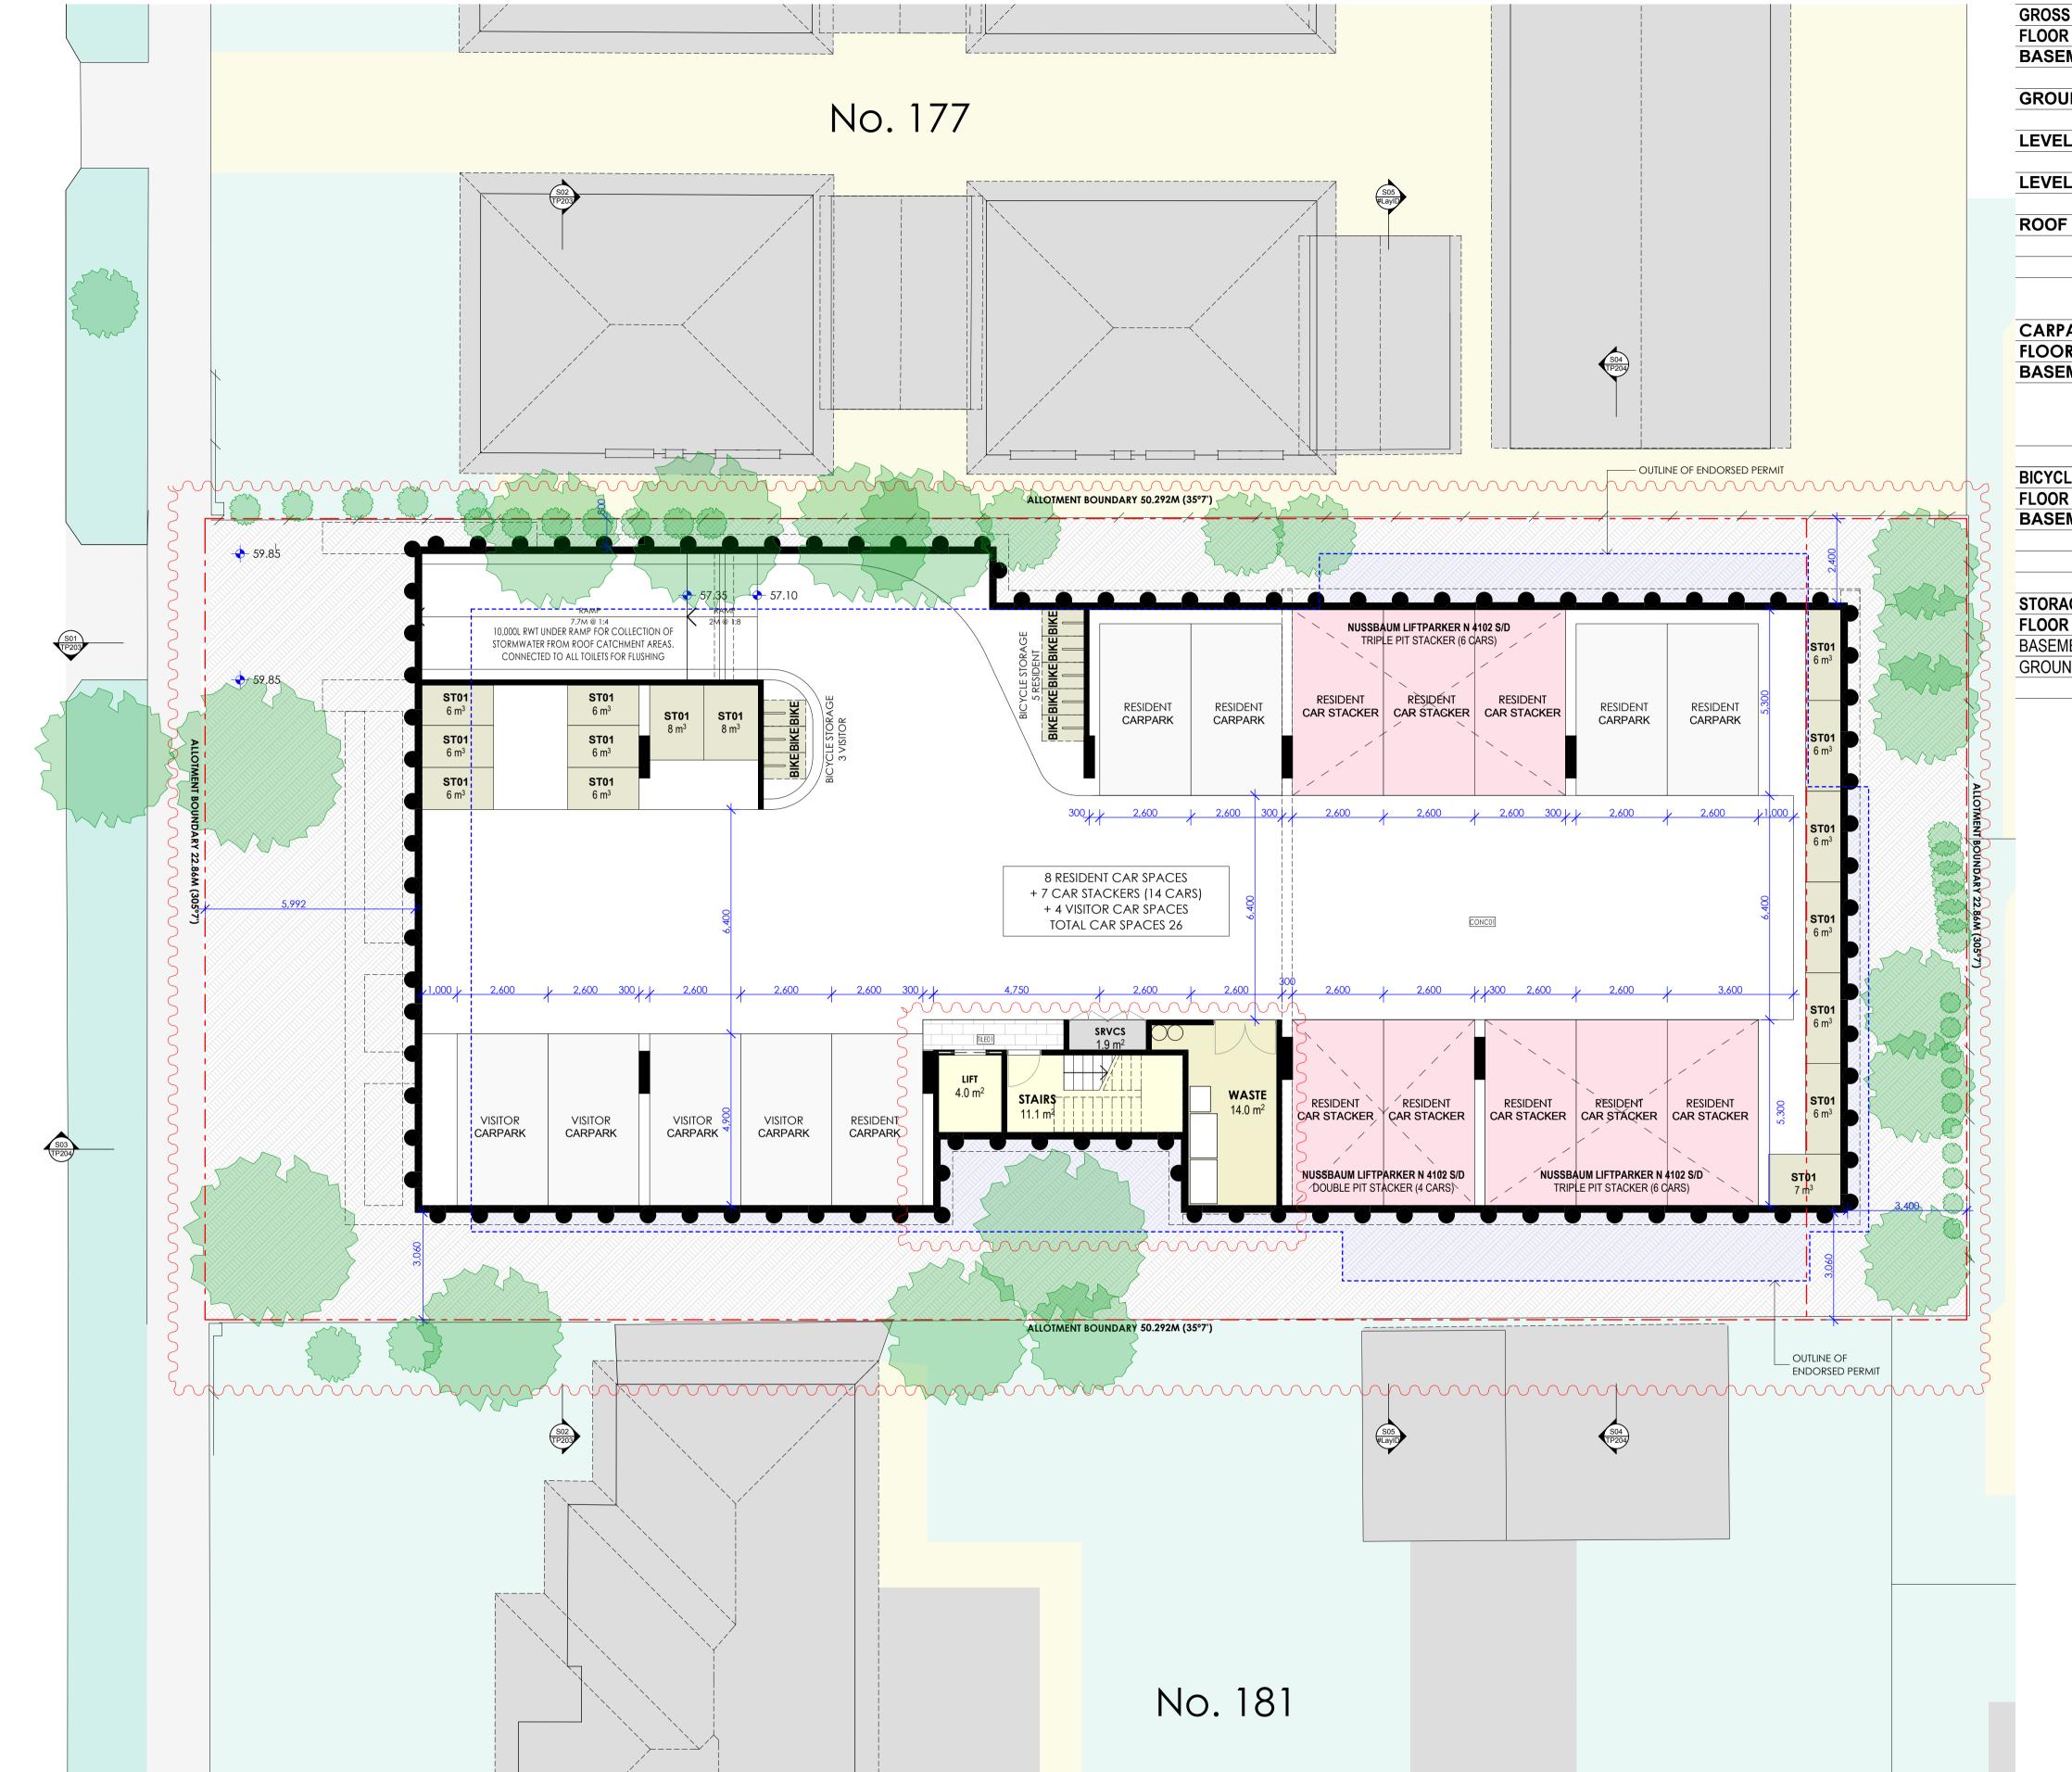

GROSS AREA SCHEDULE (EXCL. TERRACE)										
FLOOR	ZONE NAME	<b>MEASURED AREA</b>								
BASEMENT										
	GROSS BASEMENT AREA	687								
<b>GROUND LEVEL</b>										
	GROSS BUILDING AREA	638								
LEVEL 1										
	GROSS BUILDING AREA	643								
LEVEL 2										
	GROSS BUILDING AREA	446								
ROOF LEVEL										
	ROOF AREA	437								

2,851 m<sup>2</sup>


CARPARKING SO	CHEDULE	
FLOOR	NO.	CATEGORY
BASEMENT		
	4	CARSPACE VISITOR
	5	CARSPACE RESIDENT
	16	CARSPACE CAR STACKER

BICYCLE STORAGE	E SCHEDULE
FLOOR	NUMBER OF BIKES
BASEMENT	
	8

STORAGE CAGES SCHEDULE								
FLOOR	NUMBER OF CAGES							
BASEMENT	15							
GROUND LEVEL	7							
	22							

REASON FOR ISSUE DATE 08.12.2016 ISSUE FOR PLANNING APPROVAL 10.03.2017 RSBS/RECPROSE FICA CIDINICCALPRIROVAL 23.04.2018 ISSUE FOR COMPULSORY CONFERENCE CHANGES AGREED AT COMPULSORY CONFERENCE 10.05.2018 ISSUE REASON FOR ISSUE

ISSUE REASON FOR ISSUE DATE

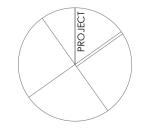

COPYRIGHT OF THIS DRAWING AND THE DESIGN DESCRIBED HEREIN IS VESTED IN CAISSON DESIGN GROUP PTY LTD

BEFORE COMMENCING ANY WORK CONTRACTORS MUST VERIFY ALL DIMENSIONS AND LEVELS ON THE SITE AND SUBMIT ALL SHOP DRAWINGS AND COST VARIATIONS TO THE ARCHITECT FOR THEIR WRITTEN APPROVAL

ARCHITECTURE GAISSON

CAISSON DESIGN GROUP PTY LTD TRADING AS ARCHITECTURE CAISSON 14 WALLACE AVE TOORAK VICTORIA 3142 AUSTRALIA ABN 56 607 067 925

ACN 607 067 925 PH +61 3 9988 1919

WWW.CAISSON.COM.AU

PROJECT CARINISH ROAD APARTMENTS **ADDRESS** 179 CARINISH ROAD, CLAYTON VIC

**DWG TITLE** BASEMENT LEVEL DWG NO. REVISION

PROJECT NO.

16018

WITHOUT PREJUDICE


SCALE 10.05.2018 1:100 @A1 AZ/CB/JW



ISSUE	REASON FOR ISSUE	DATE
TP01	ISSUE FOR PLANNING APPROVAL	08.12.2016
TP02	RESPONSE TO COUNCIL RFI	14.03.2017
TP03	ISSUE FOR COMPULSORY CONFERENCE	23.04.2018
TP04	CHANGES AGREED AT COMPULSORY CONFERENCE	10.05.2018

1220F	Κt	=A3	۱F	Ok	( 15	)SC	JE																D <i>F</i>	۱۱۶	=		
	 ٠.		 					 	 		÷		 	÷	 	 	 		 	 	 	÷				 	

ISSUE	REASON FOR ISSUE	DATE

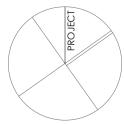

THE DESIGN DESCRIBED HEREIN IS VESTED IN CAISSON DESIGN GROUP PTY LTD


BEFORE COMMENCING ANY WORK CONTRACTORS MUST VERIFY ALL DIMENSIONS AND LEVELS ON THE SITE AND SUBMIT ALL SHOP DRAWINGS AND COST VARIATIONS ARCHITECTURE TO THE ARCHITECT FOR THEIR GAISSON WRITTEN APPROVAL

	CAISSON DESIGN GROUP PTY TRADING AS ARCHITECTURE CAISSON
	SUITE 3 14 WALLACE AVE TOORAK VICTORIA 3142 AUSTRALIA
RF	ABN 56 607 067 925 ACN 607 067 925

WWW.CAISSON.COM.AU

CARINISH ROAD APARTMENTS **ADDRESS** 179 CARINISH ROAD, CLAYTON VIC **DWG TITLE** 


**GROUND LEVEL** DWG NO. SCALE REVISION 10.05.2018 1:100 @A1 AZ/CB/JW TP104

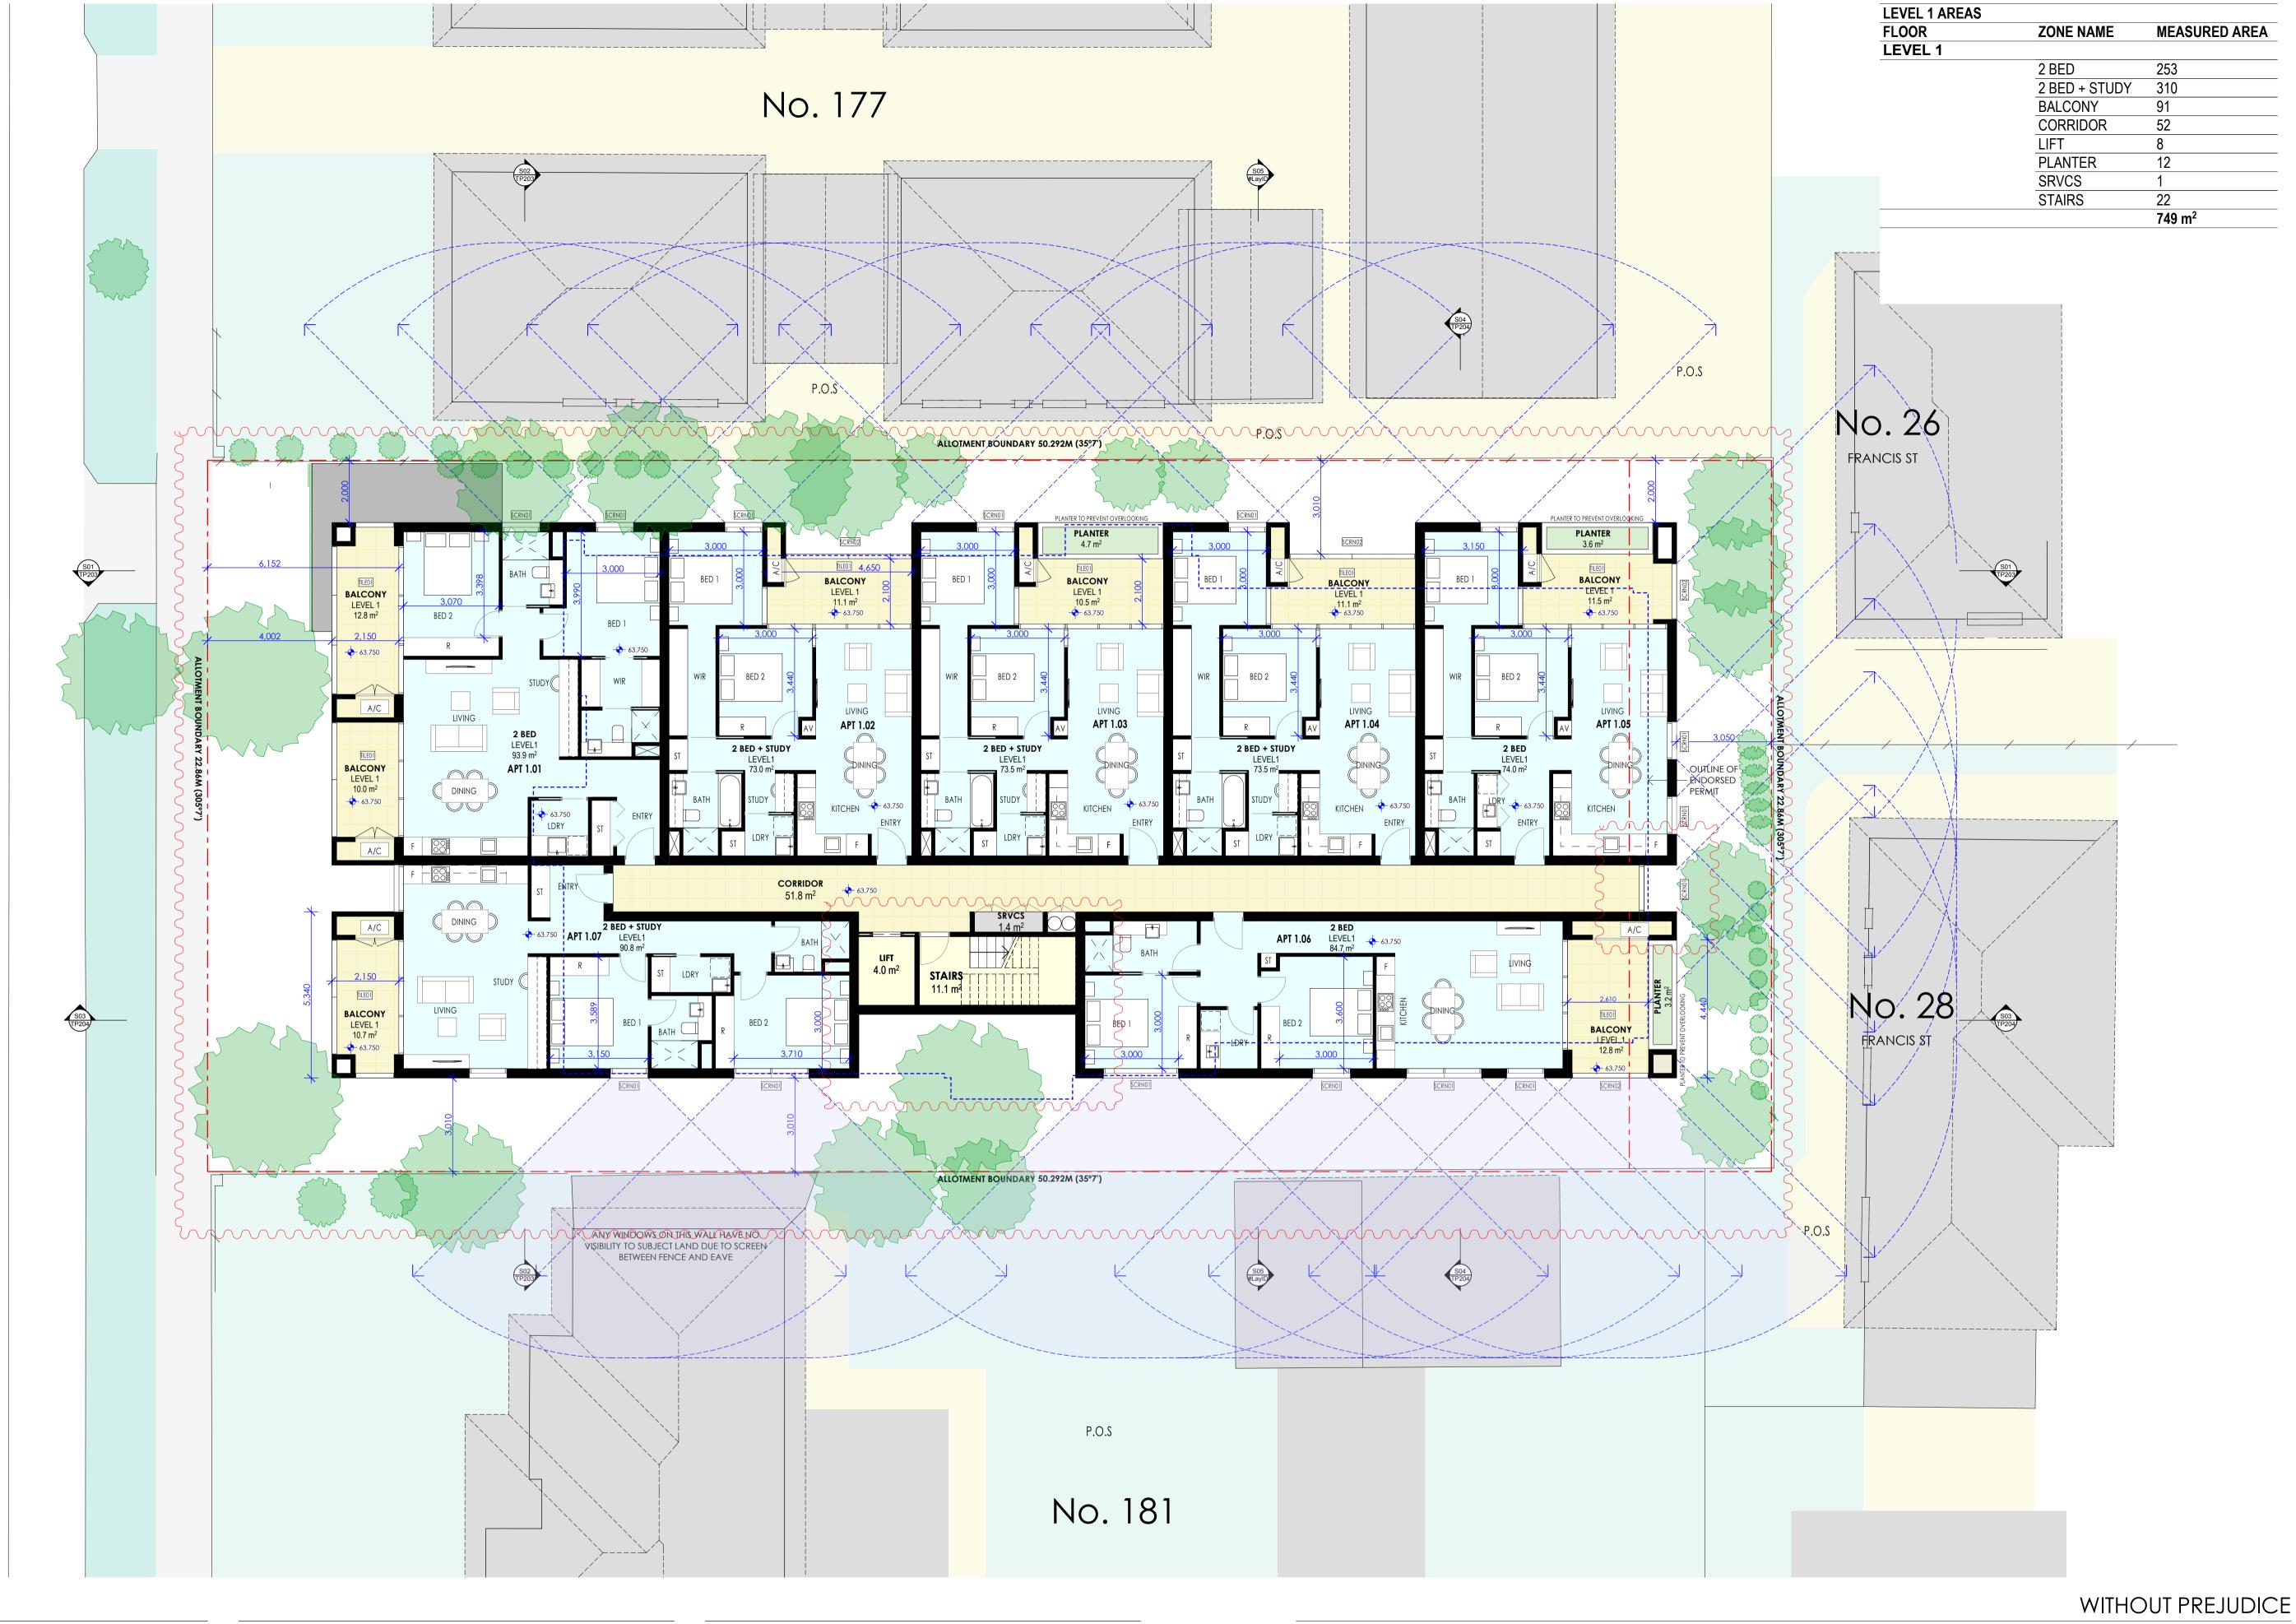

ISSUE	REASON FOR ISSUE	DATE
TP01	ISSUE FOR PLANNING APPROVAL	08.12.2016
TFR022	RESPECTAGE FLAGONING CAPPROVAL	10.03.2017
TP03	ISSUE FOR COMPULSORY CONFERENCE	23.04.2018
TP04	CHANGES AGREED AT COMPULSORY CONFERENCE	10.05.2018

ISSUE	REASON FOR ISSUE	DATE

ISSUE	REASON FOR ISSUE	DATE

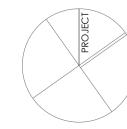

COPYRIGHT OF THIS DRAWING AND THE DESIGN DESCRIBED HEREIN IS VESTED IN CAISSON DESIGN GROUP PTY LTD

BEFORE COMMENCING ANY WORK
CONTRACTORS MUST VERIFY ALL
DIMENSIONS AND LEVELS ON THE
SITE AND SUBMIT ALL SHOP
DRAWINGS AND COST VARIATIONS
TO THE ARCHITECT FOR THEIR
WRITTEN APPROVAL

<del>-</del> O-	
ARCHITECTURE CAISSON	

CAISSON DESIGN GROUP PTY LTD
TRADING AS
ARCHITECTURE CAISSON
SUITE 3
14 WALLACE AVE TOORAK
VICTORIA 3142 AUSTRALIA

ABN 56 607 067 925 ACN 607 067 925 PH +61 3 9988 1919

WWW.CAISSON.COM.AU

PROJECT
CARINISH ROAD APARTMENTS
ADDRESS
179 CARINISH ROAD, CLAYTON VIC
DWG TITLE
LEVEL 1

DWG NO.

SH ROAD, CLAYTON VIC


REVISION DRAWN DATE SCALE
TP04 AZ/CB/JW 10.05.2018 1:100 @A1

PROJECT NO.

16018

**ROSS BUILDING AREA** 


JILDING AREA (INCL. TERRACE)
LEVEL 2
726.3 m<sup>2</sup>

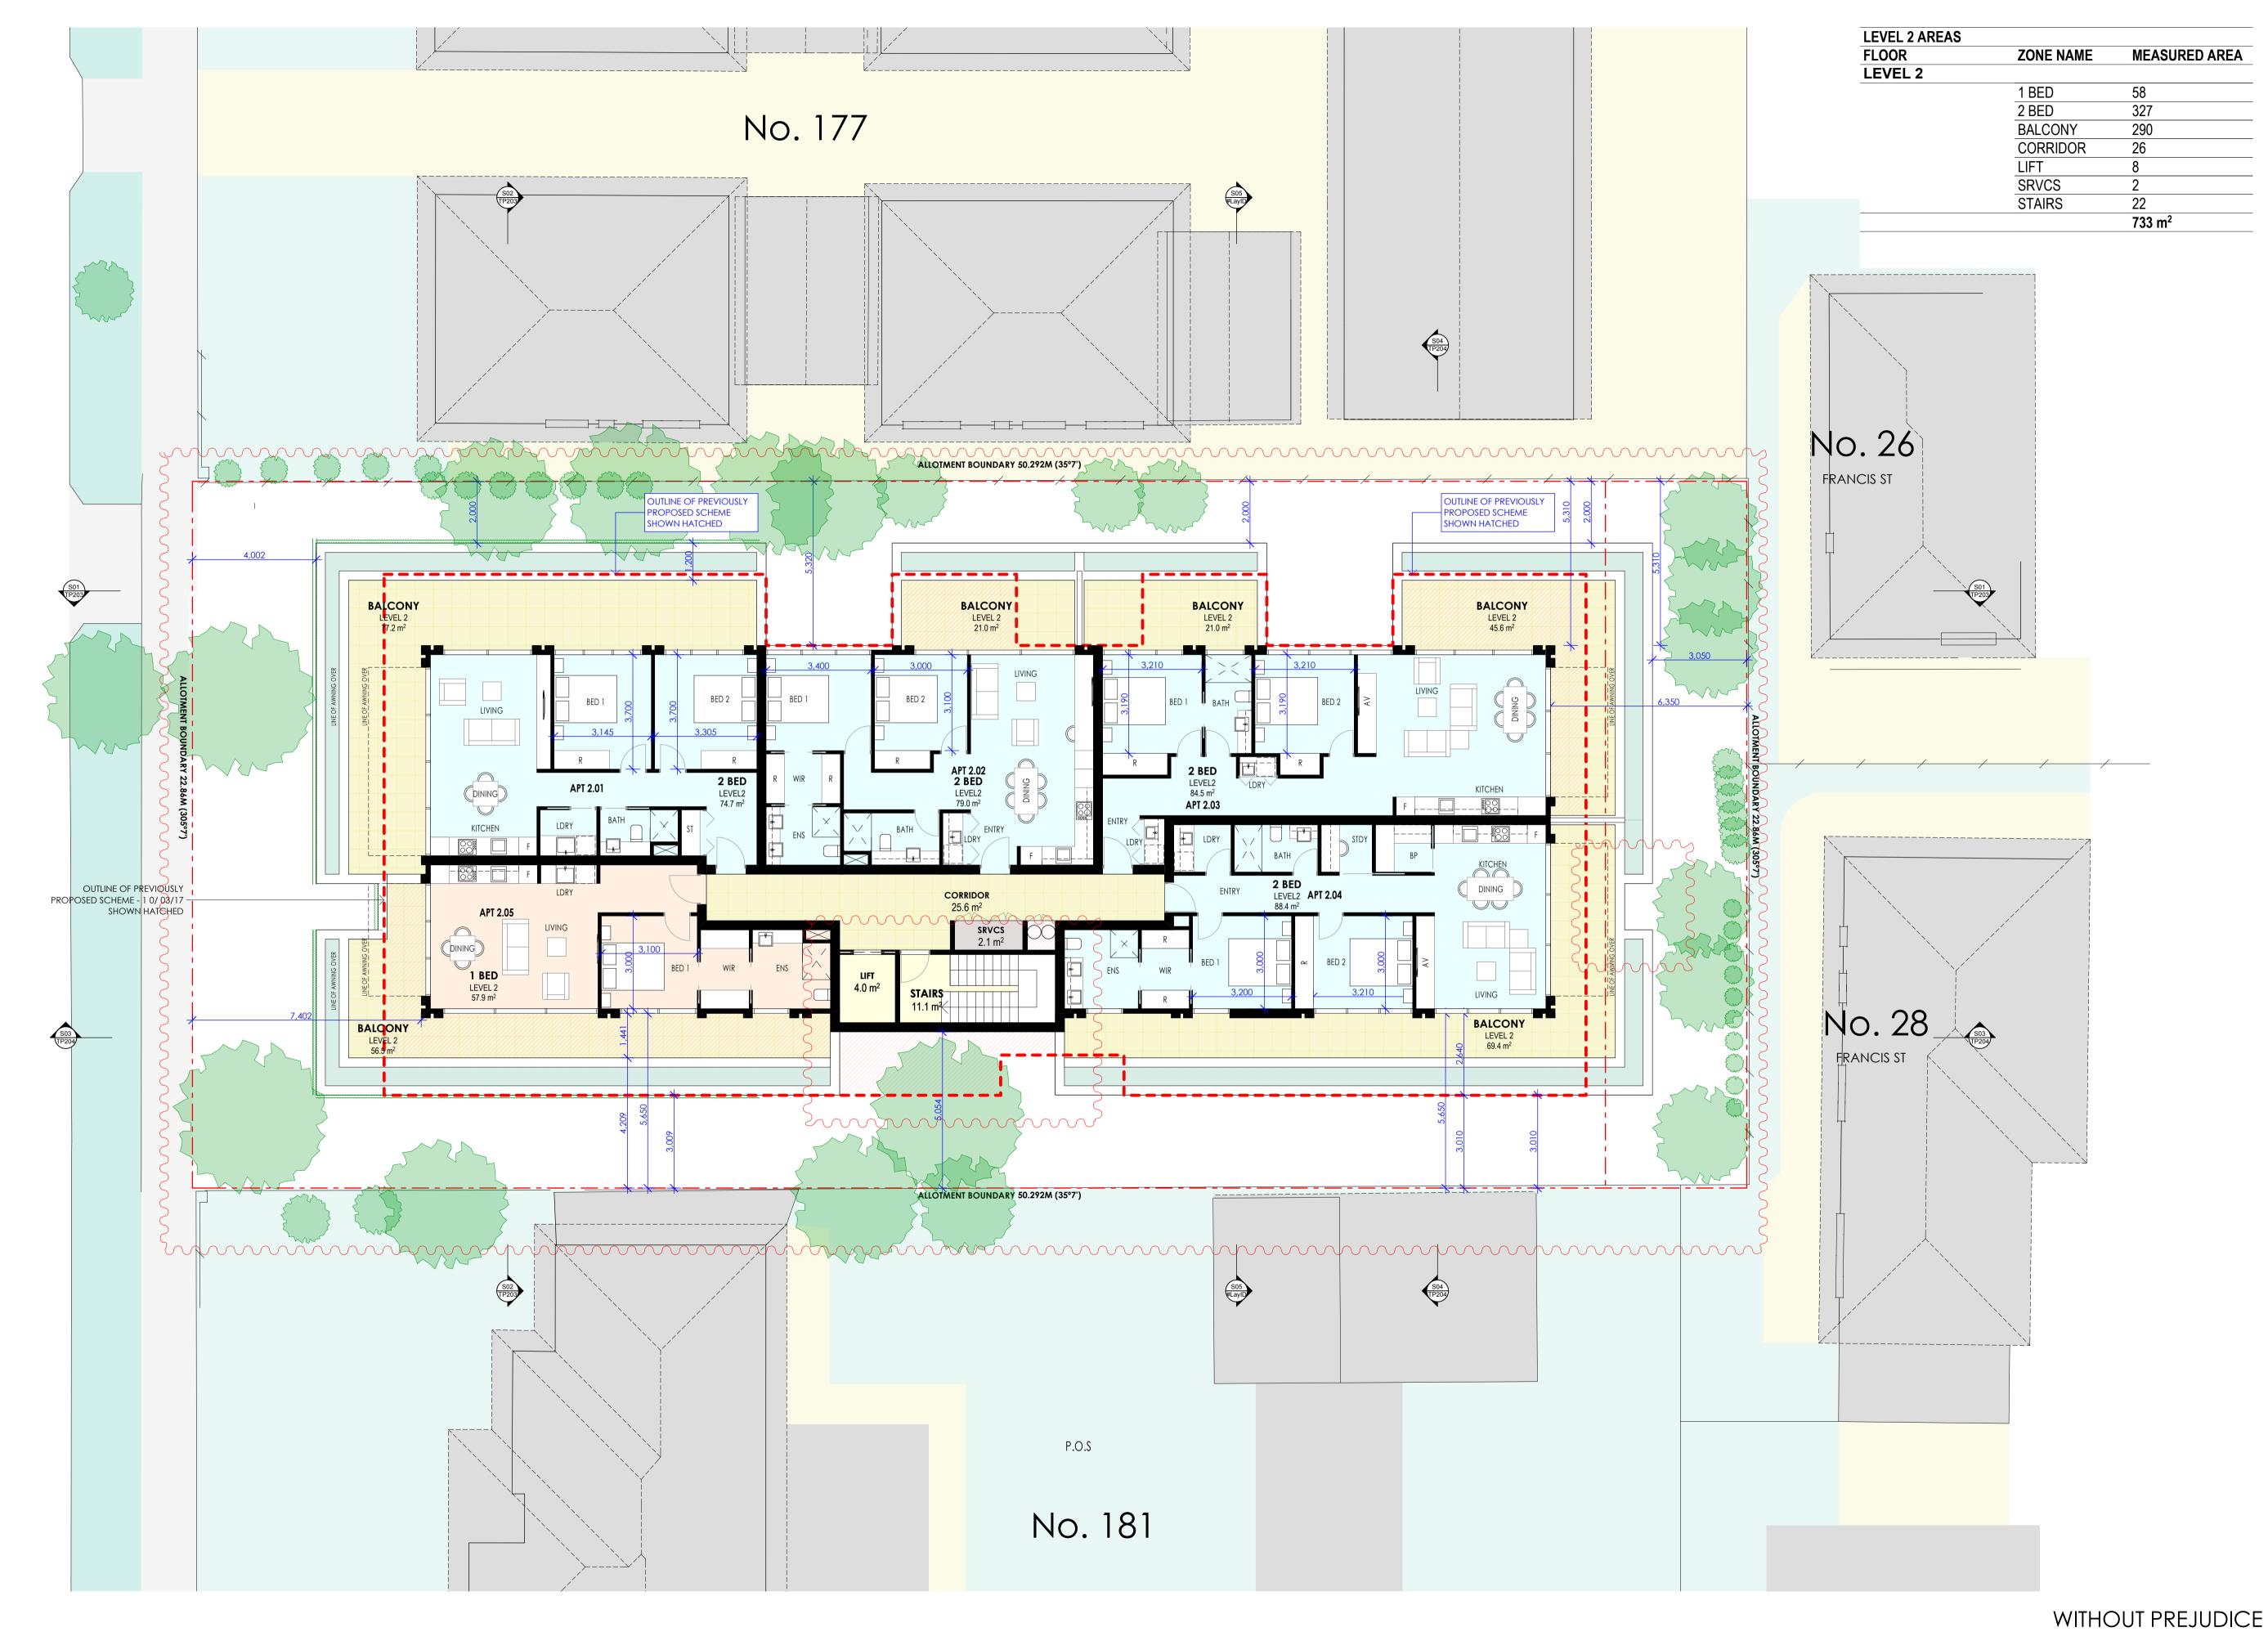

ISSUE	REASON FOR ISSUE	DATE
TP01	ISSUE FOR PLANNING APPROVAL	08.12.2016
TFR022	BESTEP DIFFE FLAGINICAP PROVAL	10.03.2017
TP03	ISSUE FOR COMPULSORY CONFERENCE	23.04.2018
TP04	CHANGES AGREED AT COMPULSORY CONFERENCE	10.05.2018

ISSUE	REASON FOR ISSUE	DATE

ISSUE	REASON FOR ISSUE	DATE

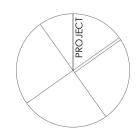

COPYRIGHT OF THIS DRAWING AND THE DESIGN DESCRIBED HEREIN IS VESTED IN CAISSON DESIGN GROUP PTY LTD

BEFORE COMMENCING ANY WORK CONTRACTORS MUST VERIFY ALL DIMENSIONS AND LEVELS ON THE SITE AND SUBMIT ALL SHOP DRAWINGS AND COST VARIATIONS TO THE ARCHITECT FOR THEIR WRITTEN APPROVAL

<u></u>	CAISSON DESIGN GROUP PTY LTD TRADING AS ARCHITECTURE CAISSON					
	SUITE 3 14 WALLACE AVE TOORAK VICTORIA 3142 AUSTRALIA					
	ABN 56 607 067 925					
ADCHITECTURE	ACN 607 067 925					
ARCHITECTURE	PH +61 3 9988 1919					
GAISSON	WWW.CAISSON.COM.AU					

CAISSON DESIGN GROUP PTY LTD TRADING AS


ARCHITECTURE CAISSON SUITE 3 14 WALLACE AVE TOORAK VICTORIA 3142 AUSTRALIA


PROJECT **ADDRESS DWG TITLE** 


CARINISH ROAD APARTMENTS 179 CARINISH ROAD, CLAYTON VIC

PROJECT NO. 16018


LEVEL 2 DWG NO. SCALE REVISION 10.05.2018 1:100 @A1 AZ/CB/JW

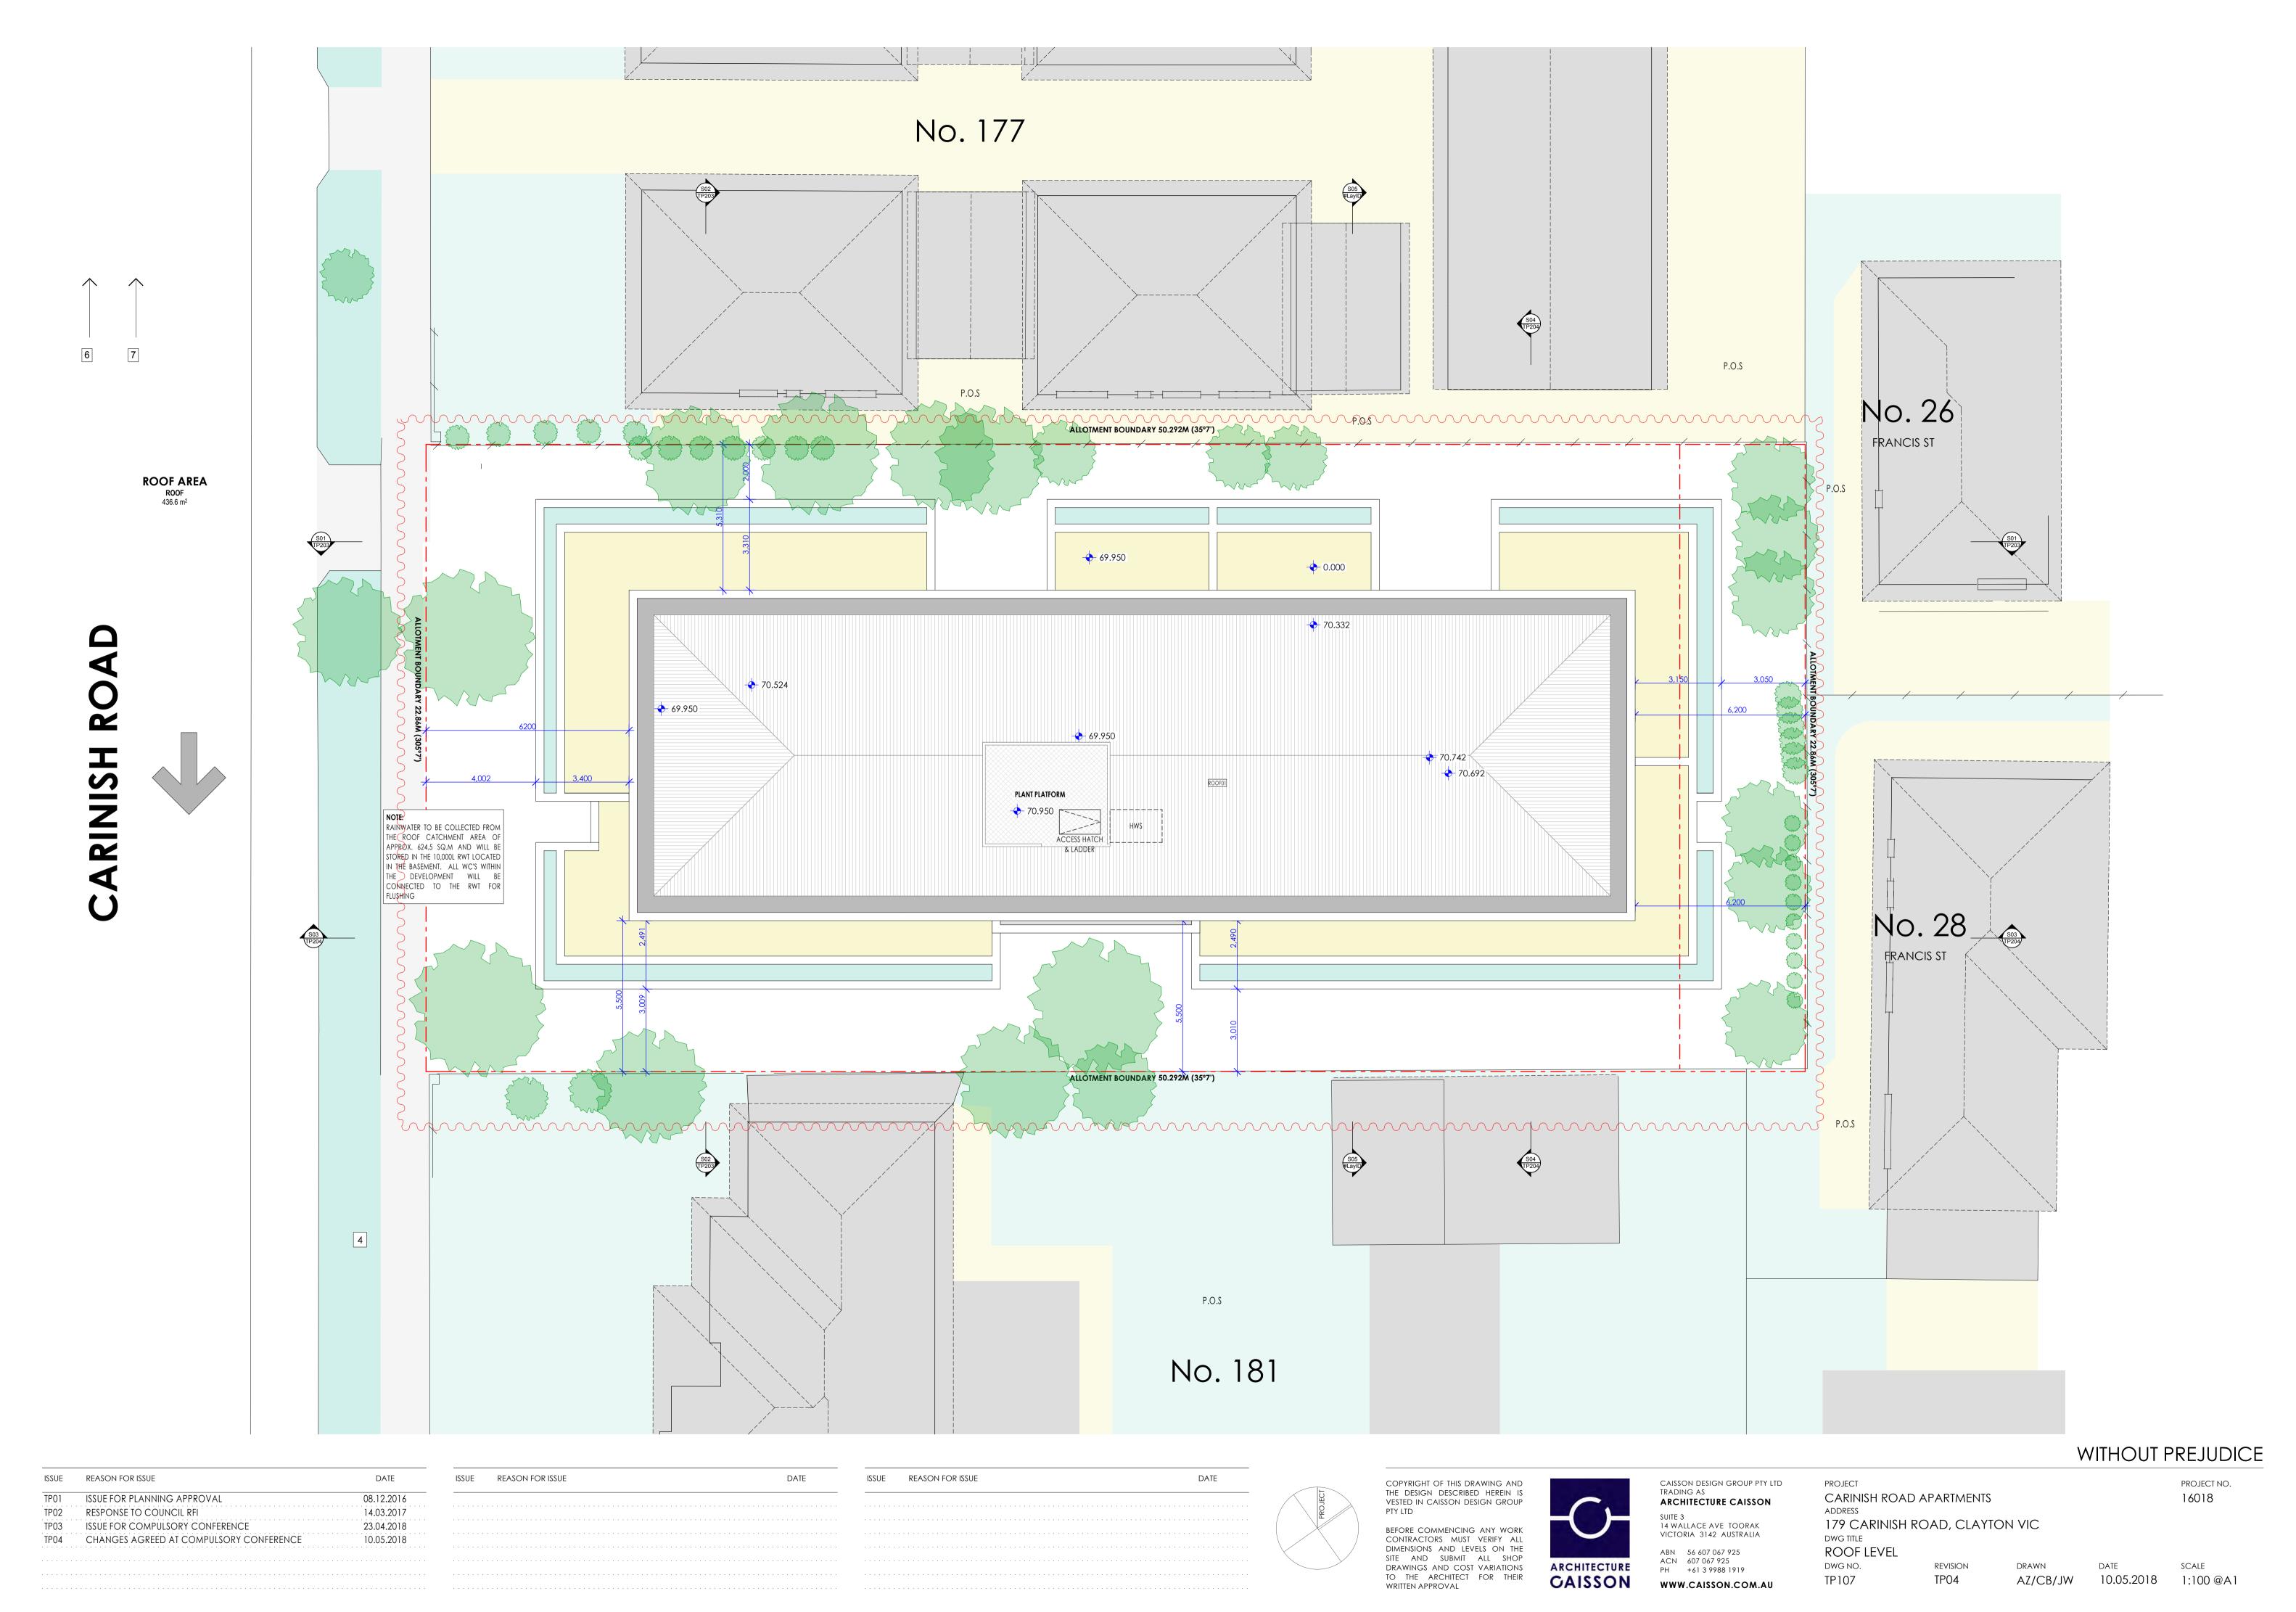


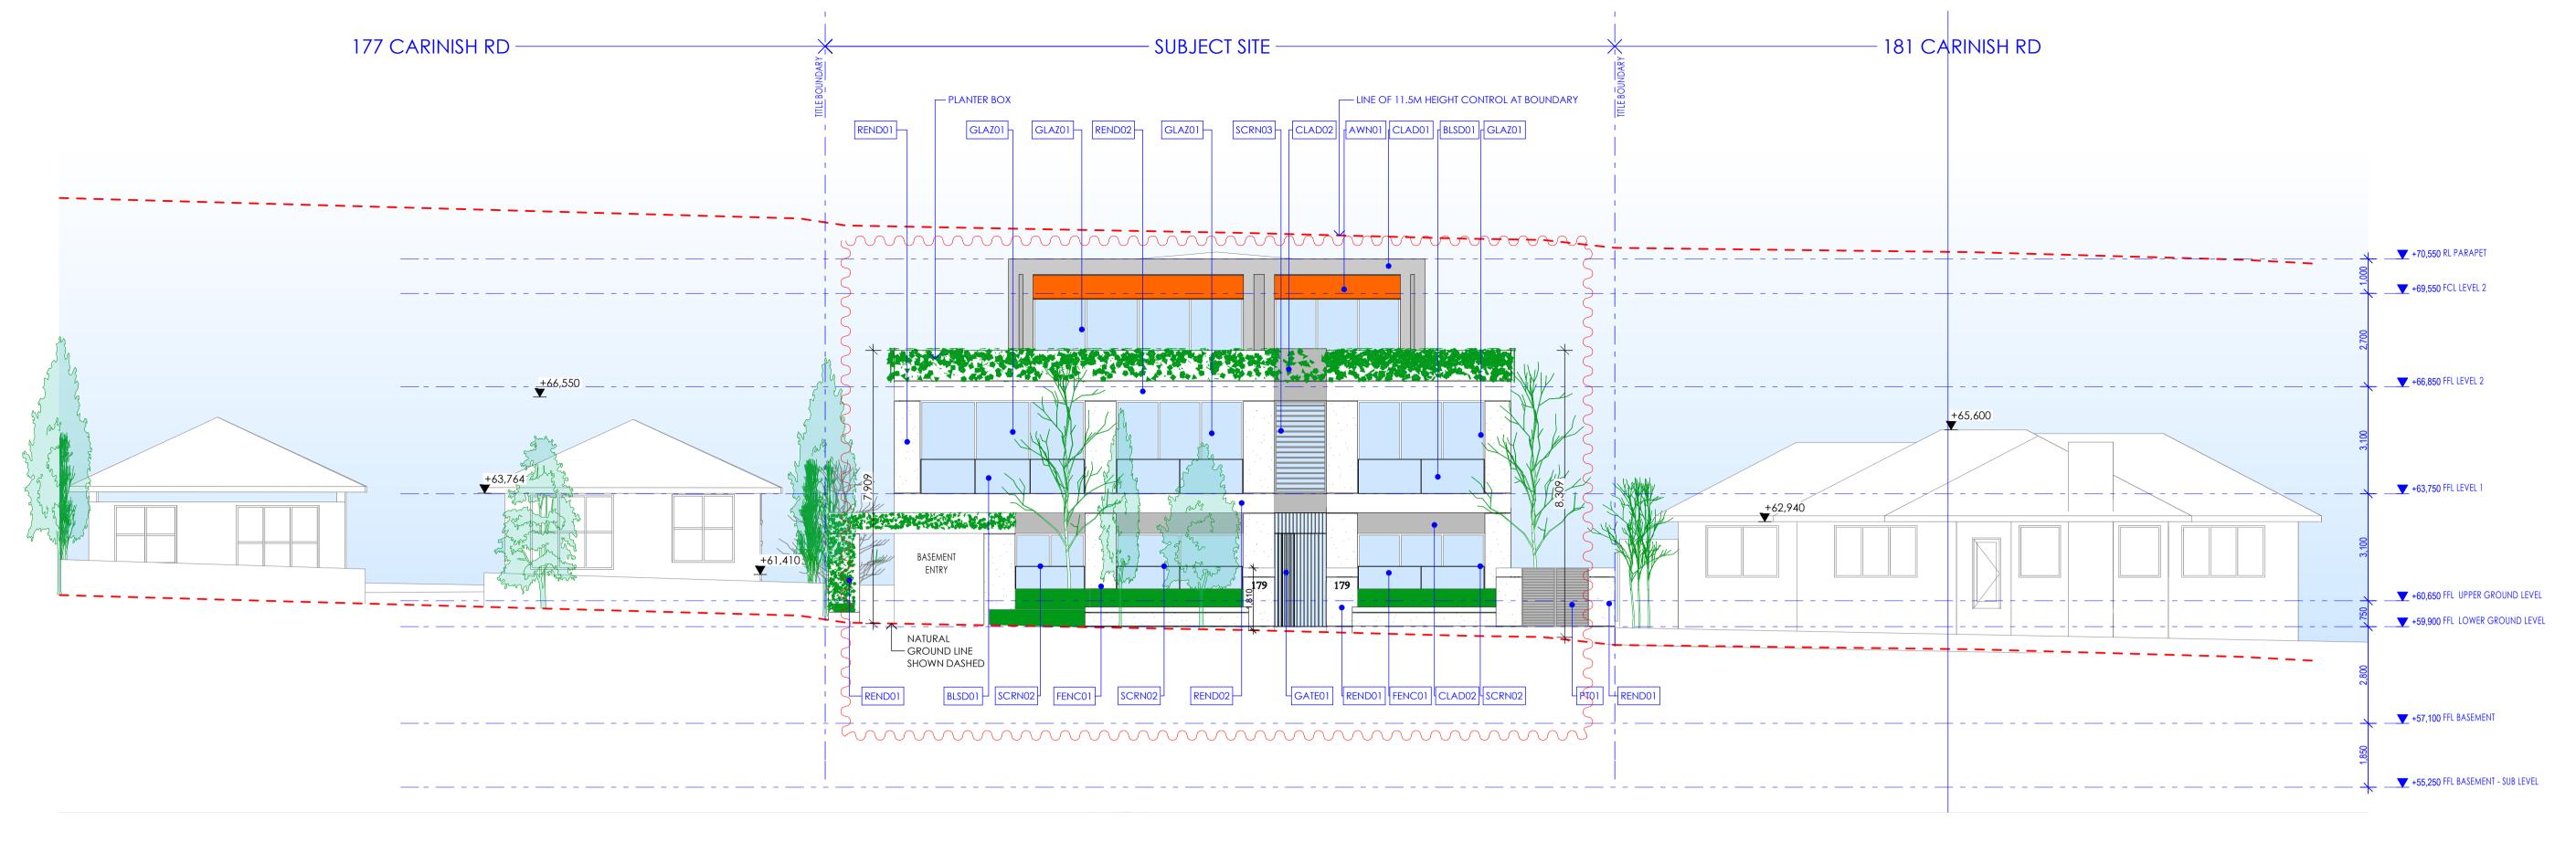

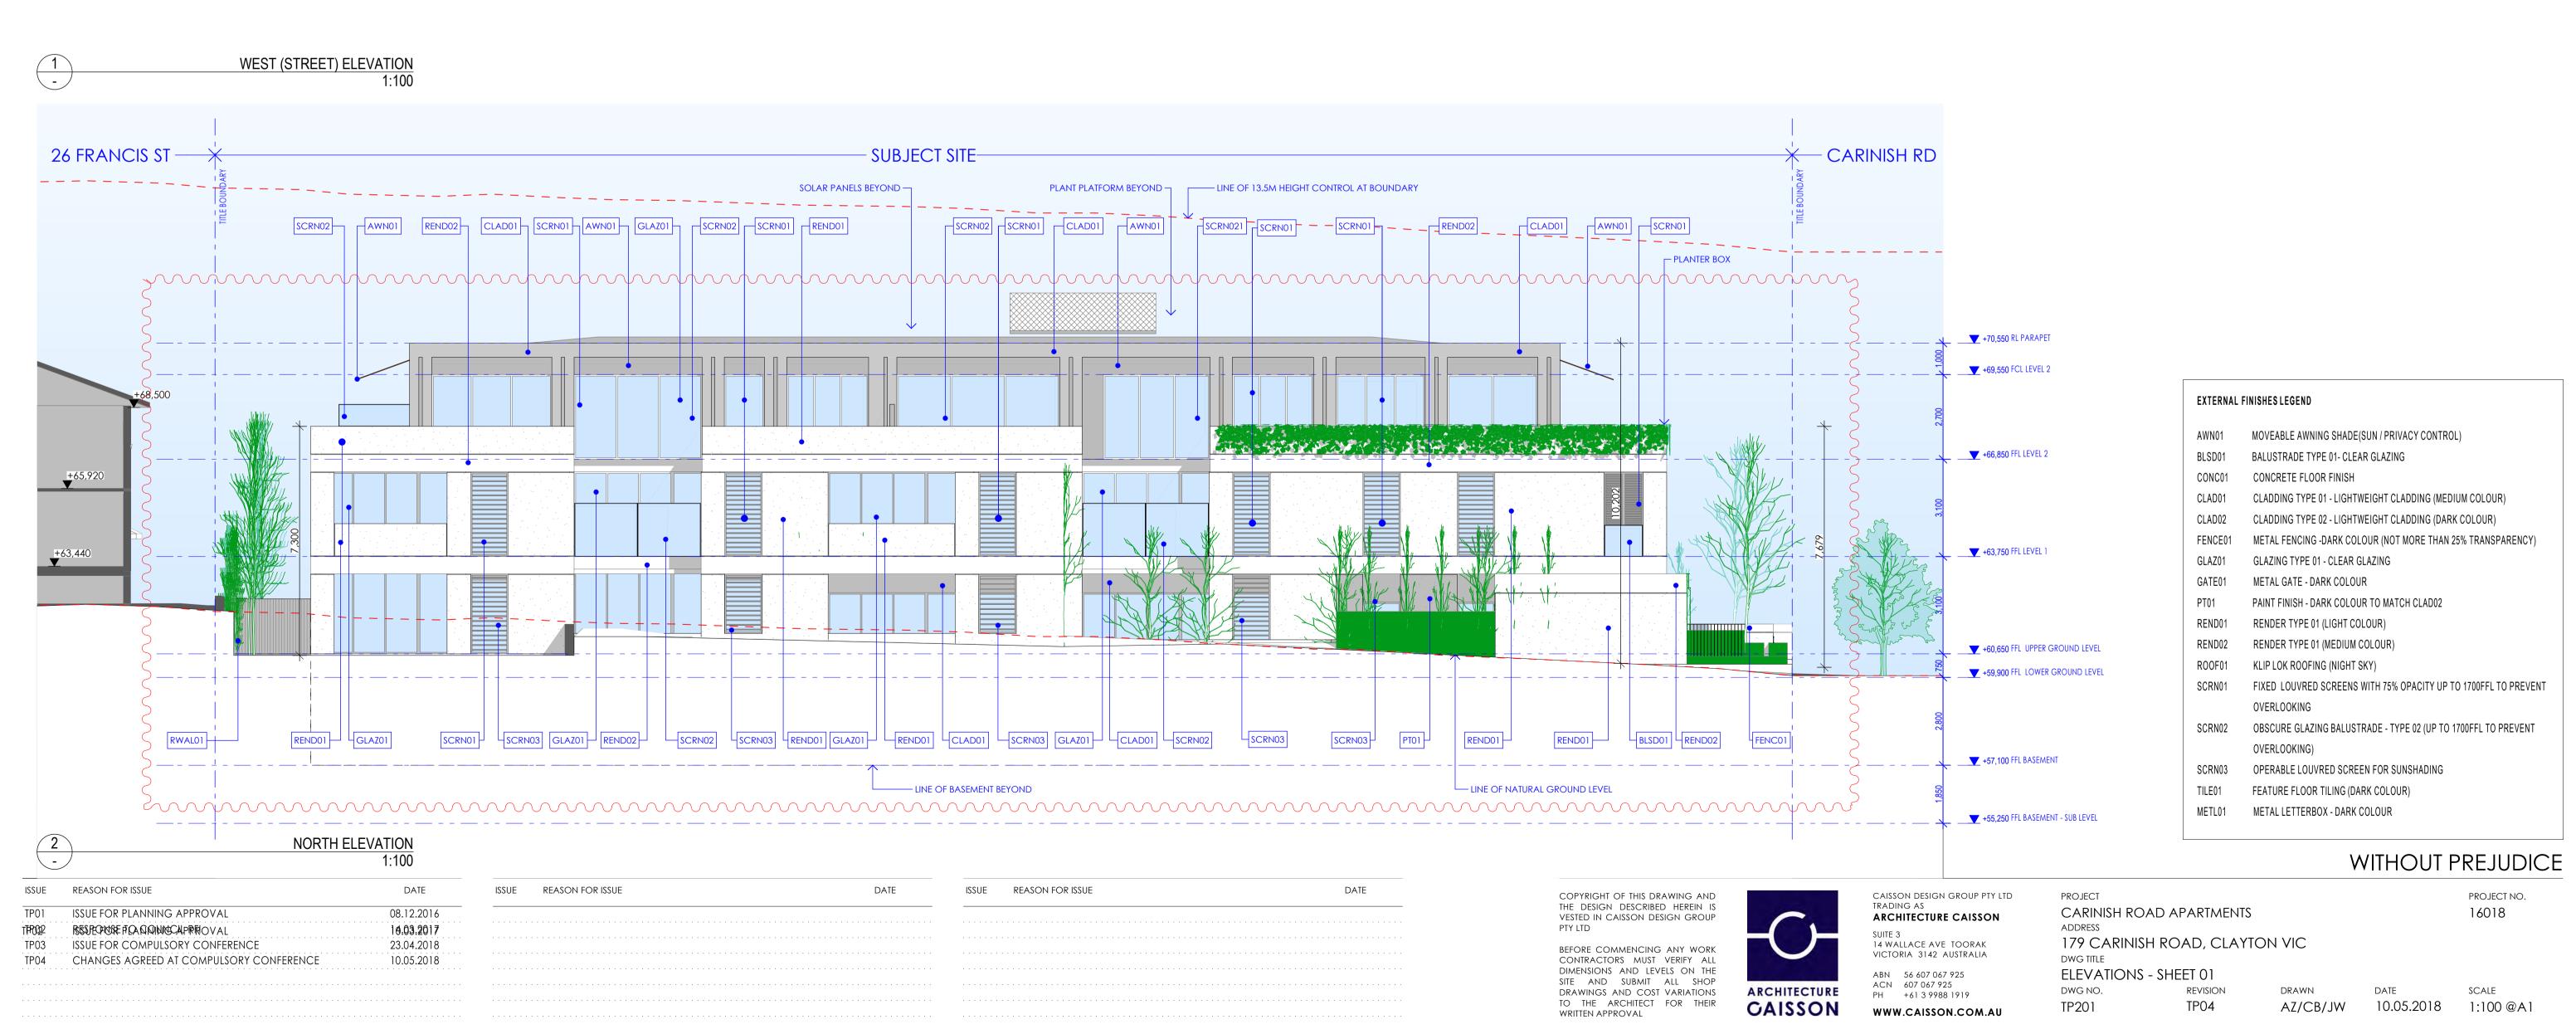



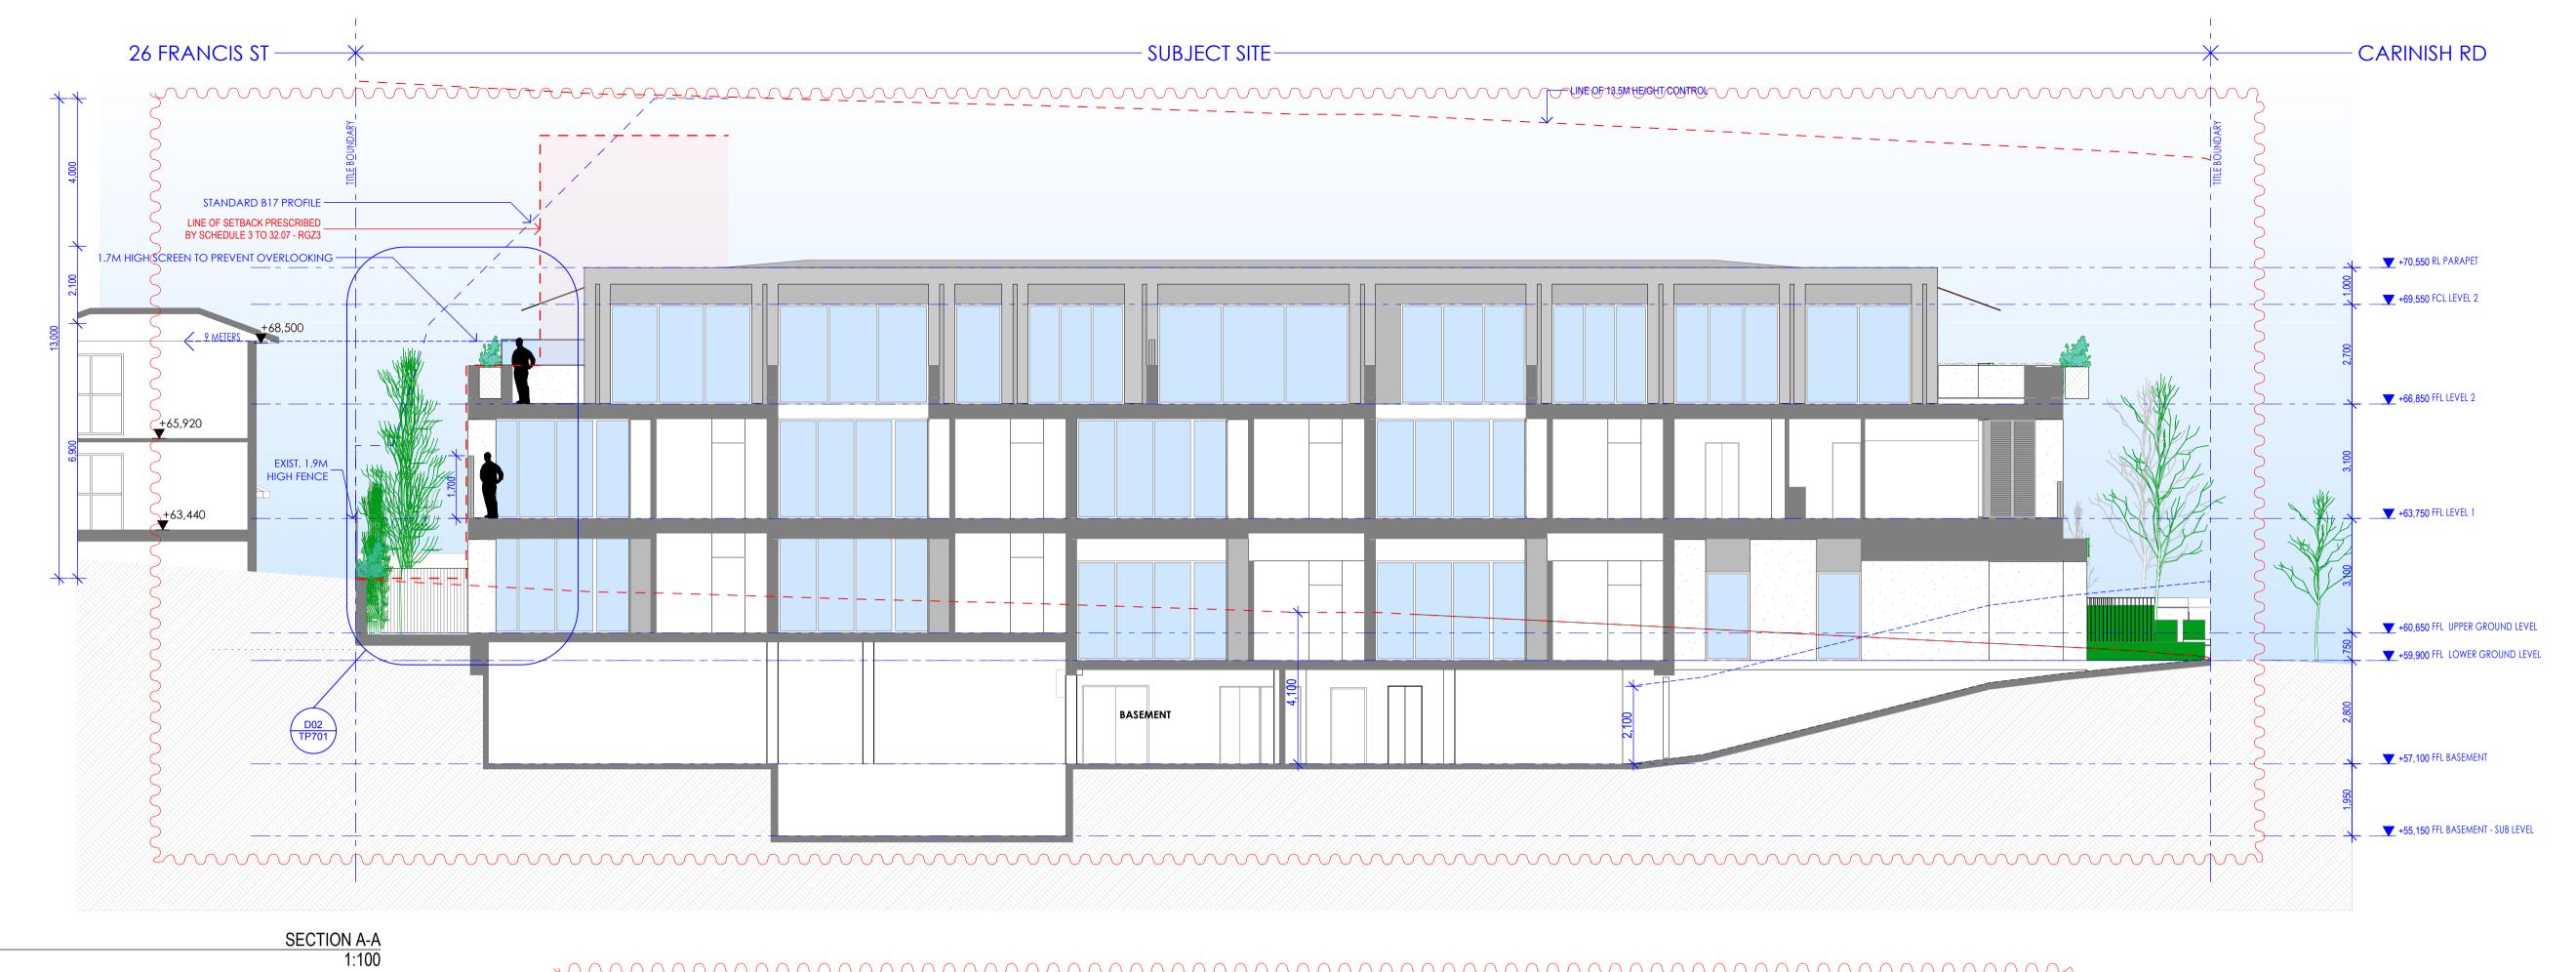

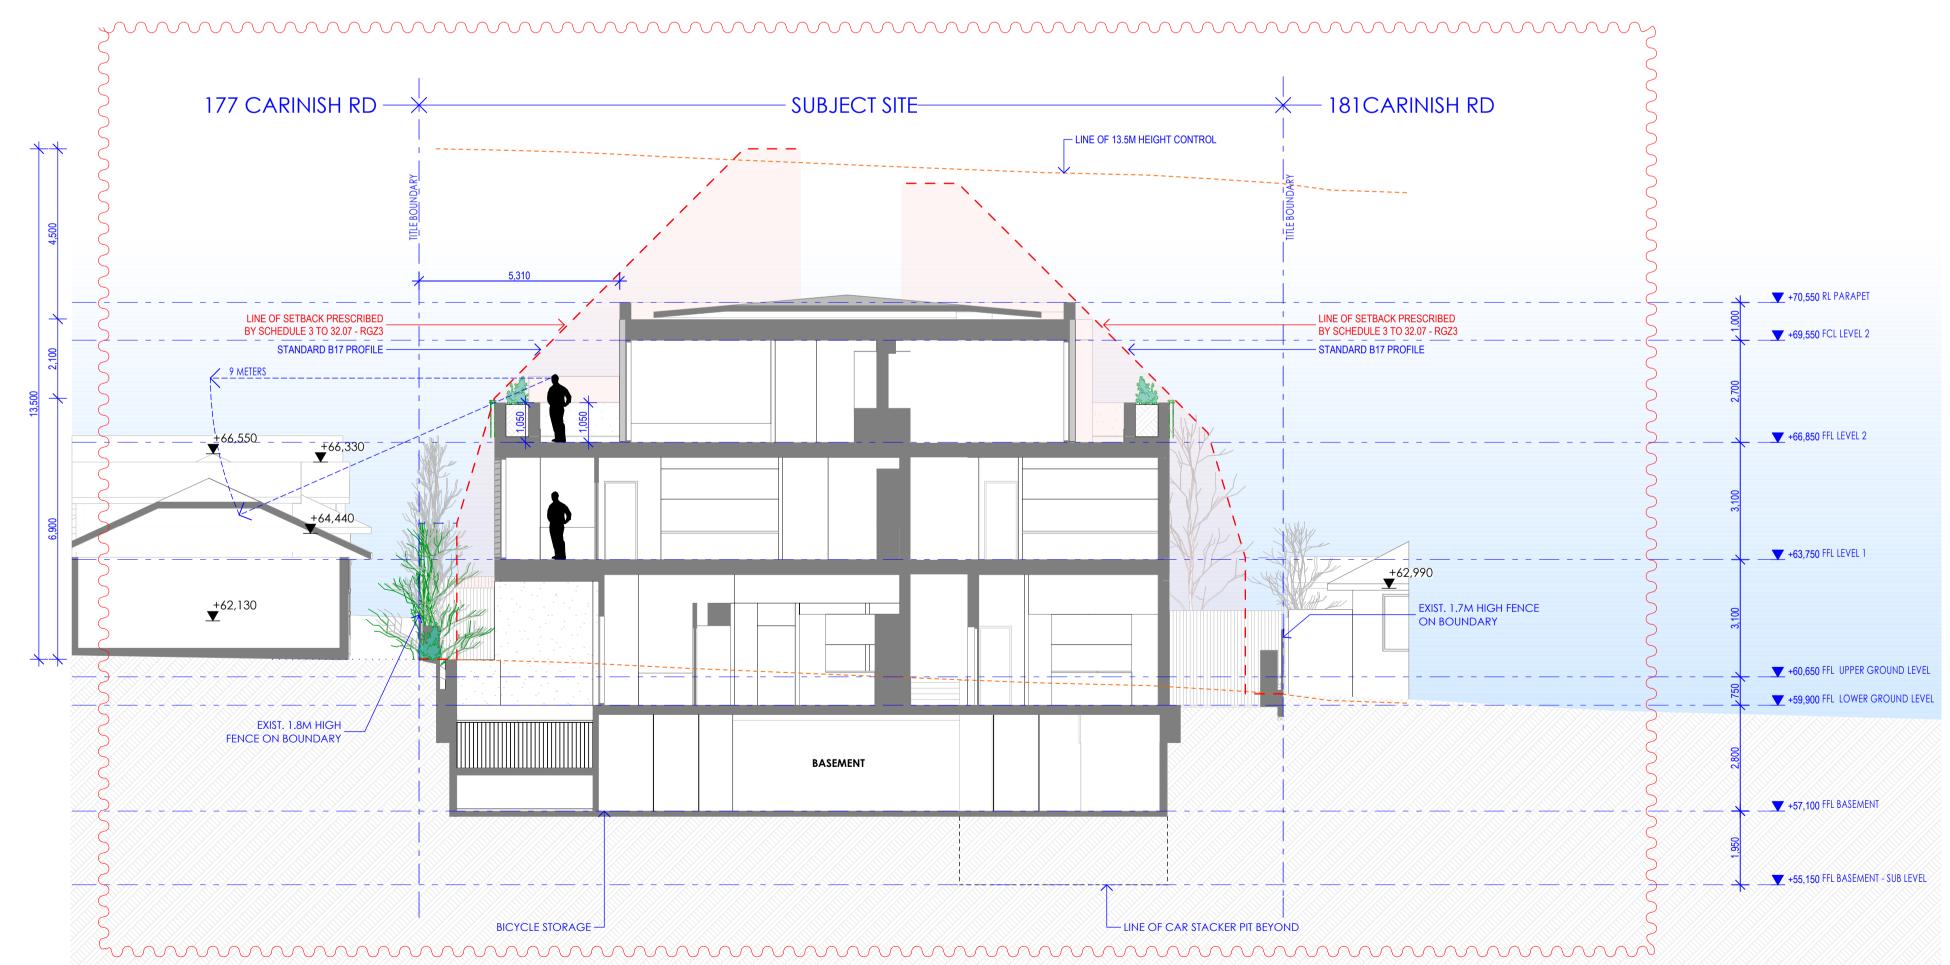

DATE

SECTION B-B 1:100

ISSUE	REASON FOR ISSUE	DATE	ISSUE	REASON FOR ISSUE	DATE	ISSUE	REASON FOR ISSUE
TP01	ISSUE FOR PLANNING APPROVAL	08.12.2016					
TP0022	RESPECTATE FLAGINICAPPROVAL	10.03.2017					
TP03	ISSUE FOR COMPULSORY CONFERENCE	23.04.2018					
TP04	CHANGES AGREED AT COMPULSORY CONFERENCE	10.05.2018					

COPYRIGHT OF THIS DRAWING AND THE DESIGN DESCRIBED HEREIN IS VESTED IN CAISSON DESIGN GROUP PTY LTD

BEFORE COMMENCING ANY WORK CONTRACTORS MUST VERIFY ALL DIMENSIONS AND LEVELS ON THE

SITE AND SUBMIT ALL SHOP DRAWINGS AND COST VARIATIONS

TO THE ARCHITECT FOR THEIR WRITTEN APPROVAL

ARCHITECTURE GAISSON

CAISSON DESIGN GROUP PTY LTD TRADING AS ARCHITECTURE CAISSON 14 WALLACE AVE TOORAK VICTORIA 3142 AUSTRALIA ABN 56 607 067 925

ACN 607 067 925 PH +61 3 9988 1919

WWW.CAISSON.COM.AU


PROJECT **ADDRESS DWG TITLE** 


CARINISH ROAD APARTMENTS 179 CARINISH ROAD, CLAYTON VIC

PROJECT NO. 16018

WITHOUT PREJUDICE

SECTIONS - SHEET 01 DWG NO. SCALE REVISION TP04 10.05.2018 1:100 @A1 AZ/CB/JW

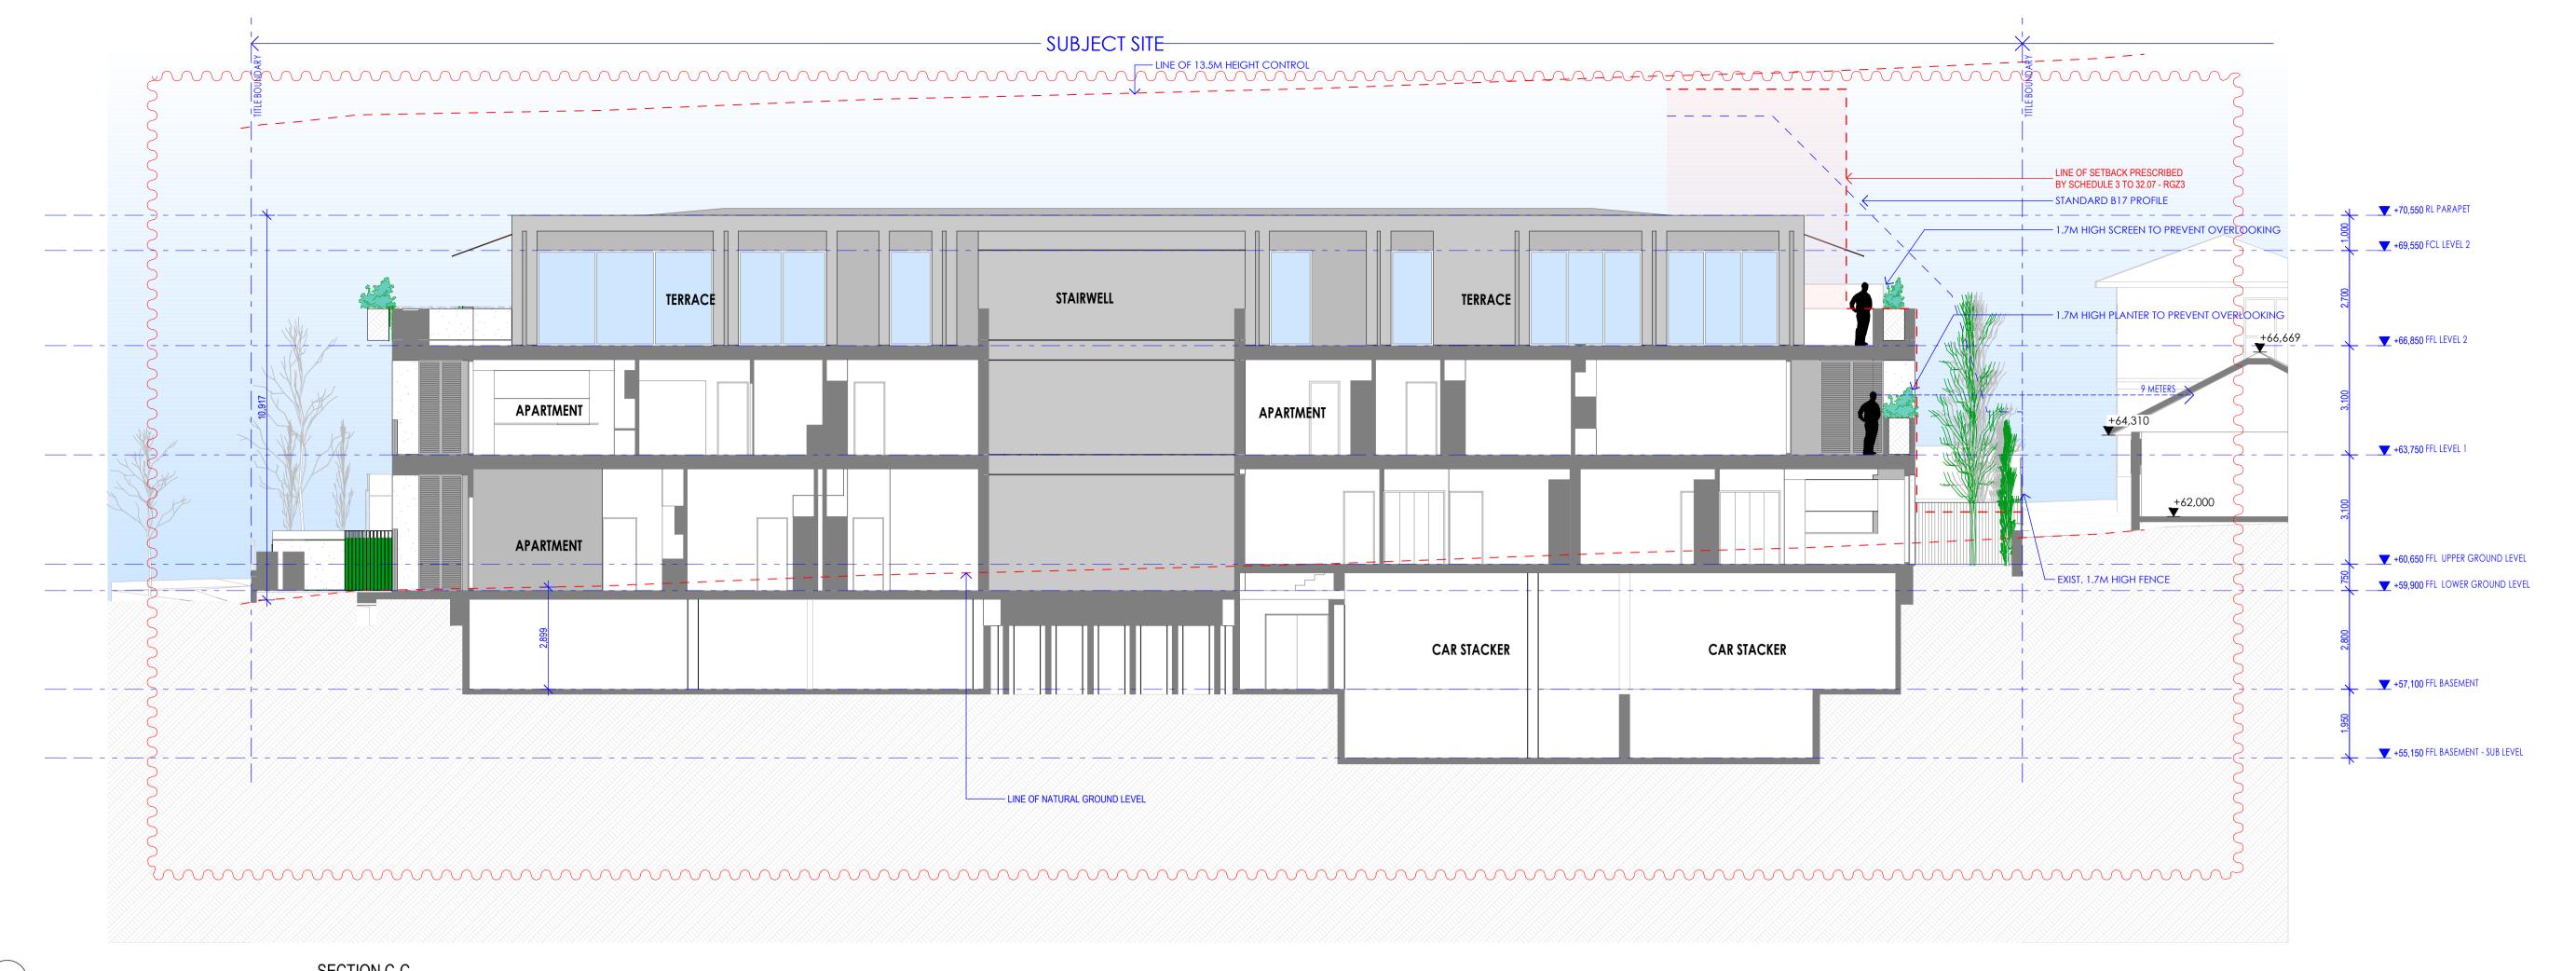

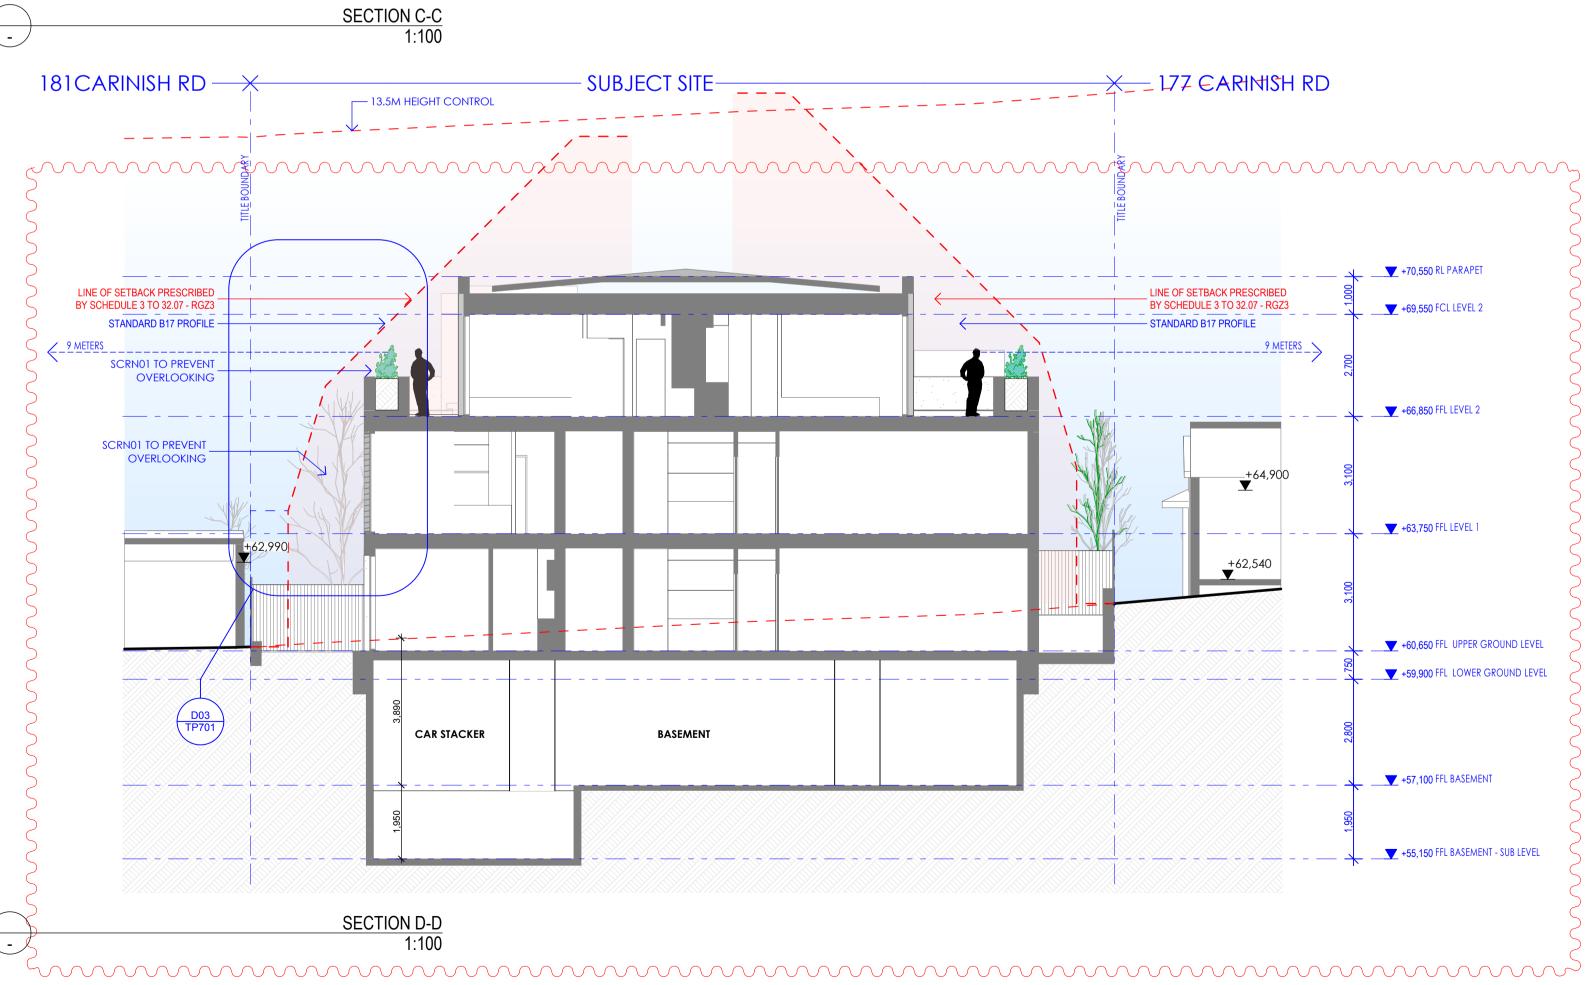

ISSUE	REASON FOR ISSUE	DATE	ISSUE	REASON FOR ISSUE	DATE	ISSUE	REASON FOR ISSUE	DATE
TP01	ISSUE FOR PLANNING APPROVAL	08.12.2016						
TFR022	RESTECTIONE FLAD MINICHPRIOVAL	10.03.2017						
TP03	ISSUE FOR COMPULSORY CONFERENCE	23.04.2018						
TP04	CHANGES AGREED AT COMPULSORY CONFERENCE	10.05.2018						

## COPYRIGHT OF THIS DRAWING AND THE DESIGN DESCRIBED HEREIN IS VESTED IN CAISSON DESIGN GROUP

PTY LTD BEFORE COMMENCING ANY WORK CONTRACTORS MUST VERIFY ALL DIMENSIONS AND LEVELS ON THE SITE AND SUBMIT ALL SHOP DRAWINGS AND COST VARIATIONS TO THE ARCHITECT FOR THEIR WRITTEN APPROVAL

# ARCHITECTURE GAISSON

CAISSON DESIGN GROUP PTY LTD trading as ARCHITECTURE CAISSON 14 WALLACE AVE TOORAK VICTORIA 3142 AUSTRALIA ABN 56 607 067 925

ACN 607 067 925 PH +61 3 9988 1919

WWW.CAISSON.COM.AU

PROJECT CARINISH ROAD APARTMENTS **ADDRESS DWG TITLE** 

DWG NO.

TP204

179 CARINISH ROAD, CLAYTON VIC SECTIONS - SHEET 02


16018 SCALE REVISION


AZ/CB/JW

WITHOUT PREJUDICE

10.05.2018 1:100 @A1

PROJECT NO.

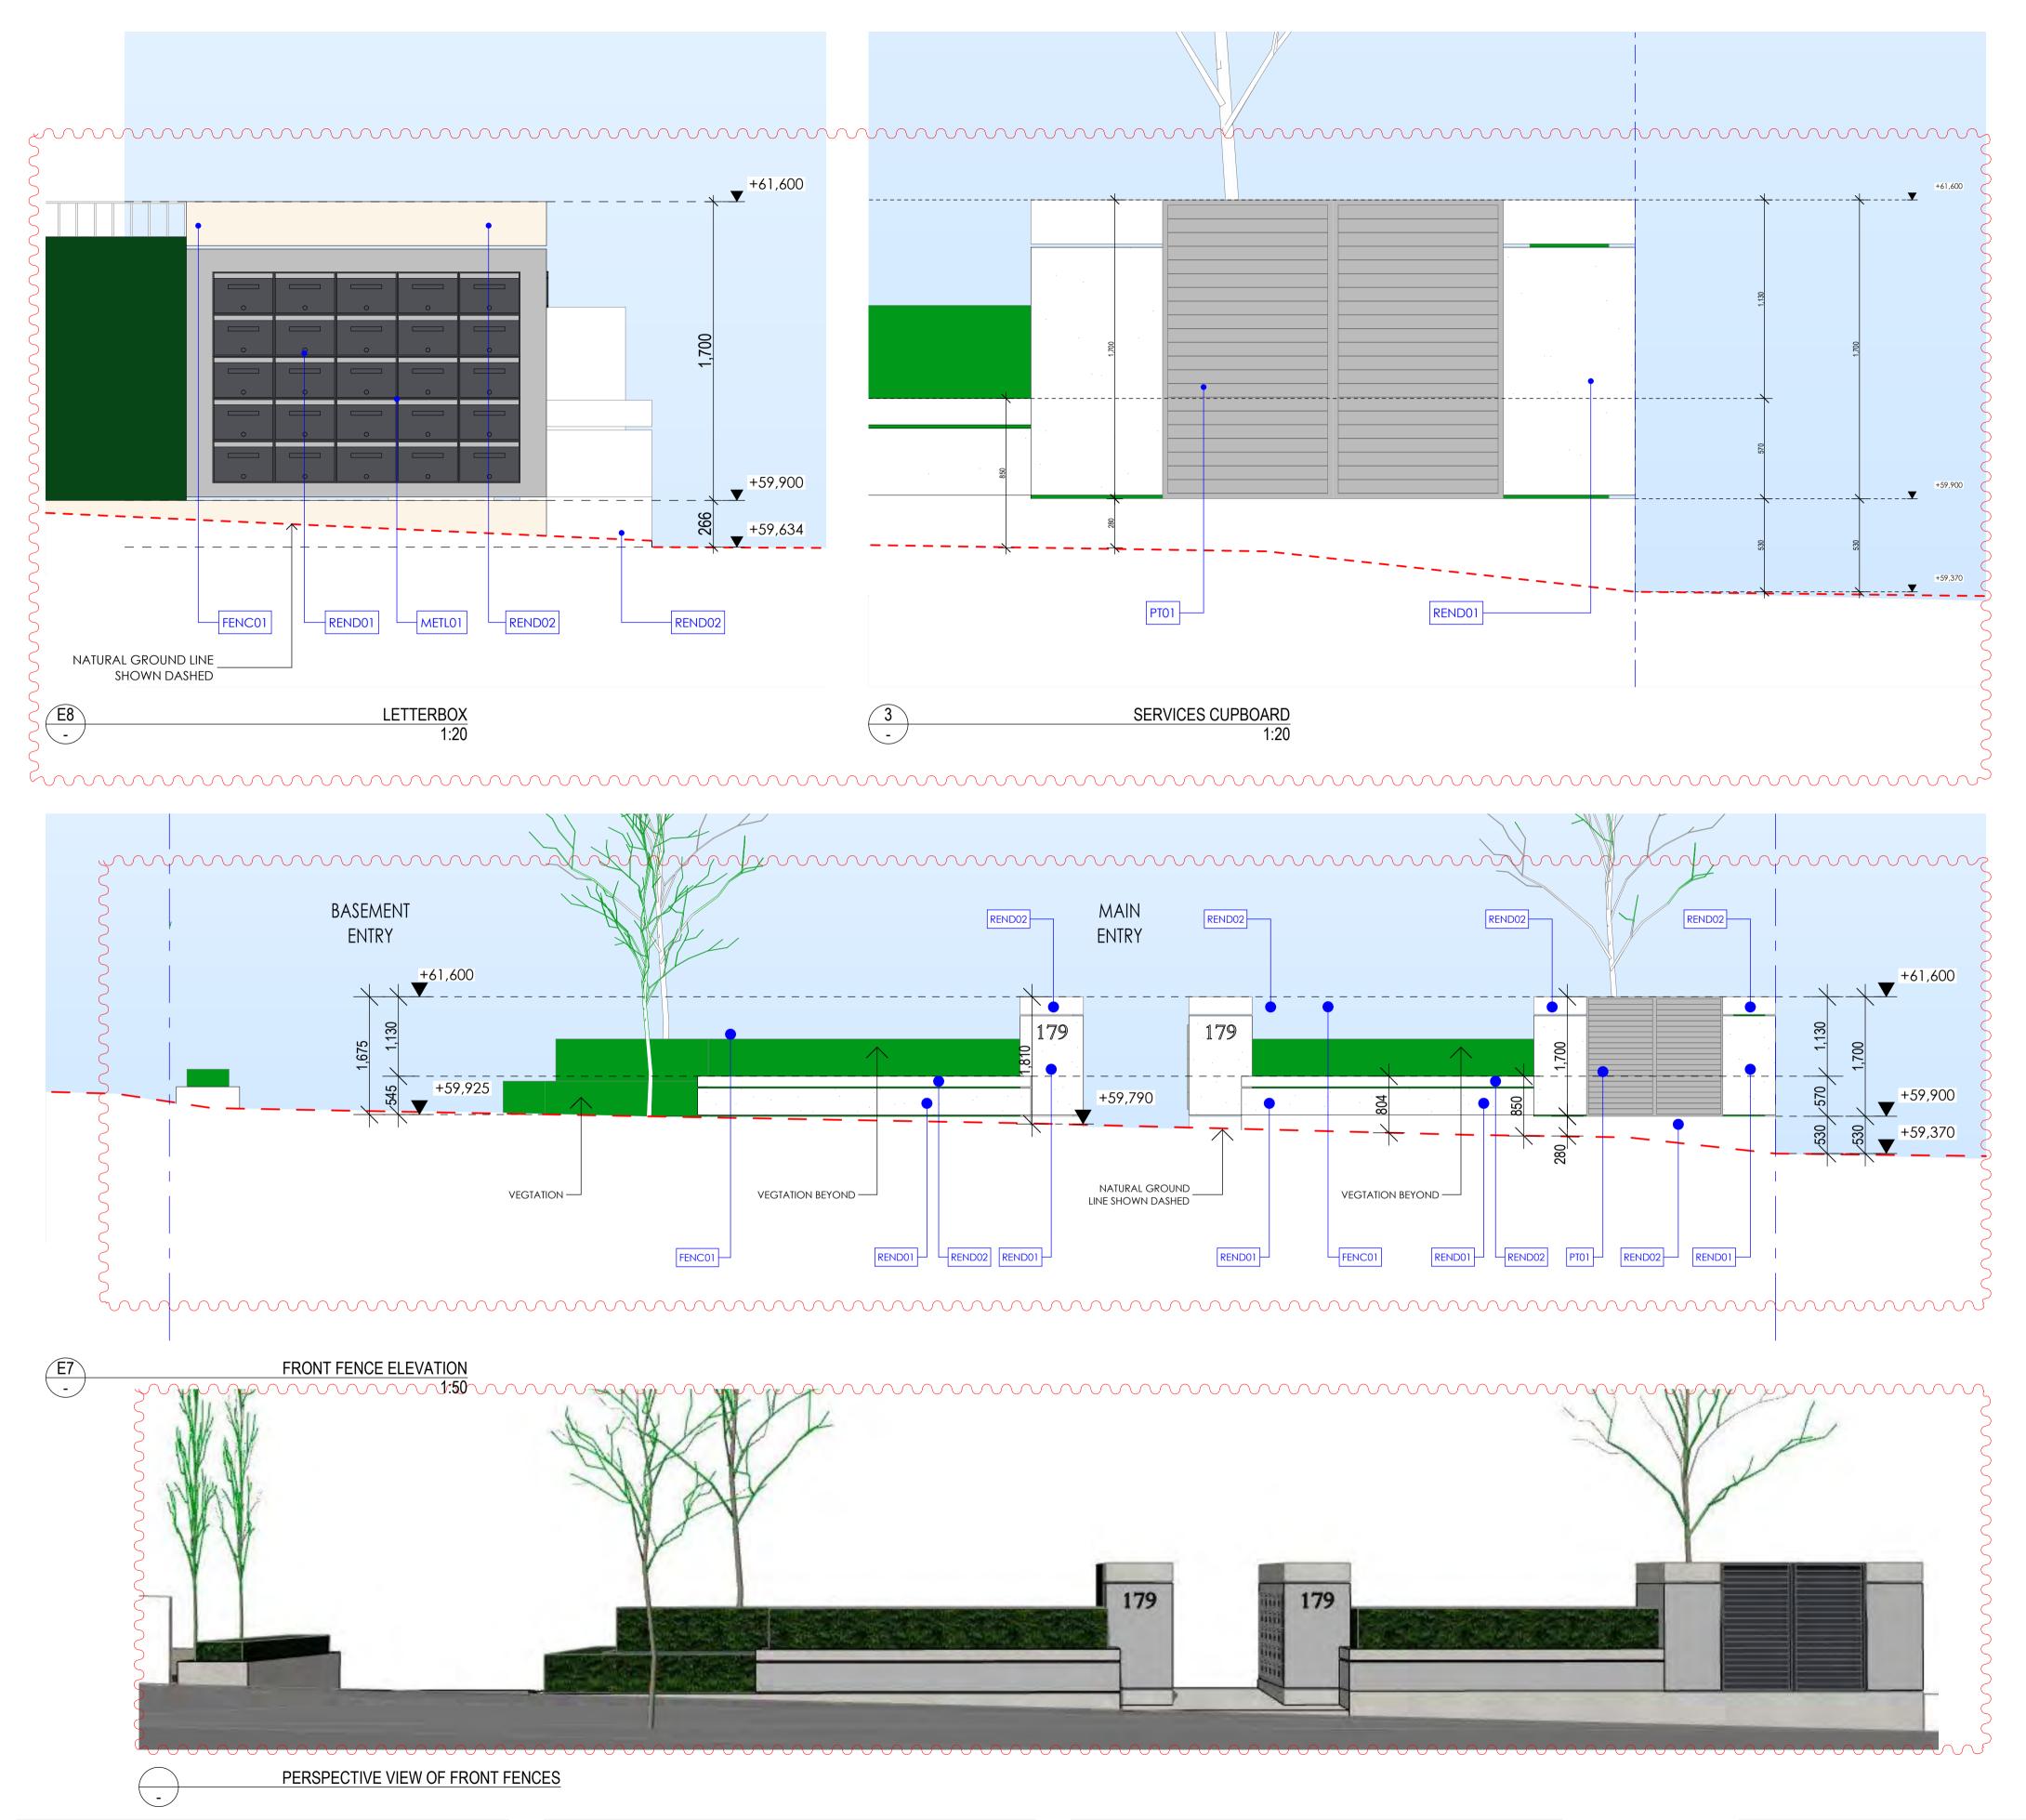

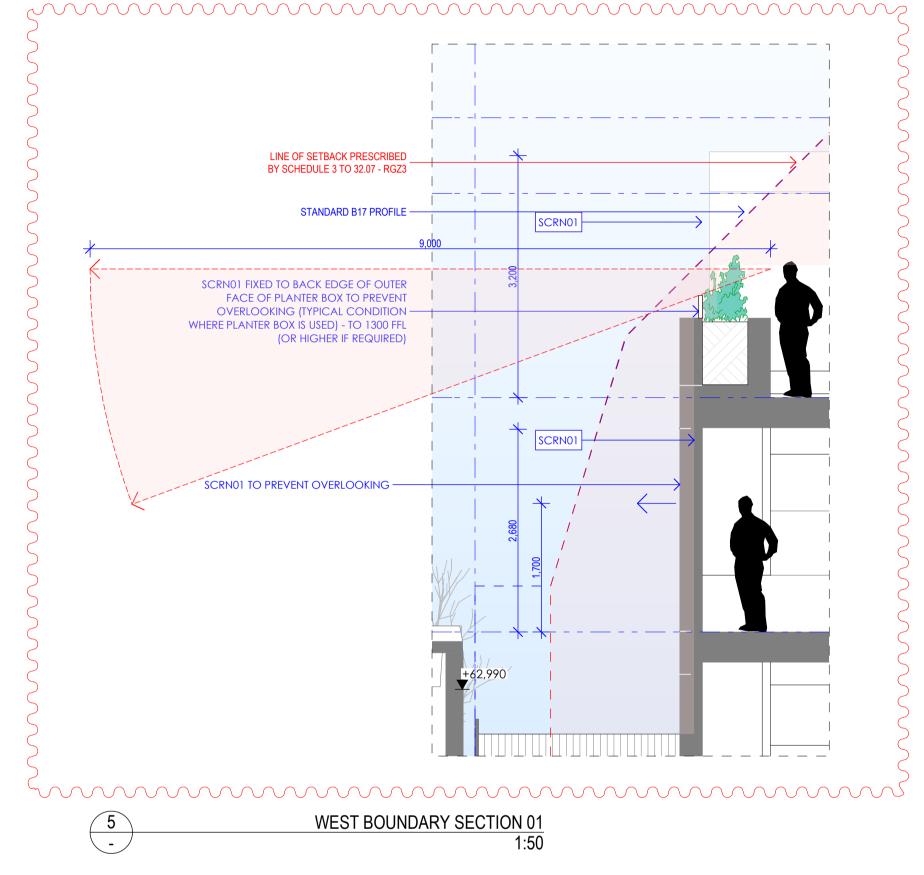

EXTERNAL	FINISHES LEGEND
AWN01	MOVEABLE AWNING SHADE(SUN / PRIVACY CONTROL)
BLSD01	BALUSTRADE TYPE 01- CLEAR GLAZING
CONC01	CONCRETE FLOOR FINISH
CLAD01	CLADDING TYPE 01 - LIGHTWEIGHT CLADDING (MEDIUM COLOUR)
CLAD02	CLADDING TYPE 02 - LIGHTWEIGHT CLADDING (DARK COLOUR)
FENCE01	METAL FENCING -DARK COLOUR (NOT MORE THAN 25% TRANSPARENCY)
GLAZ01	GLAZING TYPE 01 - CLEAR GLAZING
GATE01	METAL GATE - DARK COLOUR
PT01	PAINT FINISH - DARK COLOUR TO MATCH CLAD02
REND01	RENDER TYPE 01 (LIGHT COLOUR)
REND02	RENDER TYPE 01 (MEDIUM COLOUR)
ROOF01	KLIP LOK ROOFING (NIGHT SKY)
SCRN01	FIXED LOUVRED SCREENS WITH 75% OPACITY UP TO 1700FFL TO PREVE
	OVERLOOKING
SCRN02	OBSCURE GLAZING BALUSTRADE - TYPE 02 (UP TO 1700FFL TO PREVENT
	OVERLOOKING)
SCRN03	OPERABLE LOUVRED SCREEN FOR SUNSHADING
TILE01	FEATURE FLOOR TILING (DARK COLOUR)
METL01	METAL LETTERBOX - DARK COLOUR

# WITHOUT PREJUDICE

PROJECT NO.

16018

ISSUE	reason for issue	DATE	ISSUE REASON FOR ISSUE	DATE	ISSUE	reason for issue	DATE
TP01	ISSUE FOR PLANNING APPROVAL	08.12.2016					
TP02	RESPONSE TO COUNCIL RFI	14.03.2017					
TP03	ISSUE FOR COMPULSORY CONFERENCE	23.04.2018					
TP04	CHANGES AGREED AT COMPULSORY CONFERENCE	10.05.2018					

COPYRIGHT OF THIS DRAWING AND THE DESIGN DESCRIBED HEREIN IS VESTED IN CAISSON DESIGN GROUP PTY LTD

BEFORE COMMENCING ANY WORK CONTRACTORS MUST VERIFY ALL DIMENSIONS AND LEVELS ON THE SITE AND SUBMIT ALL SHOP DRAWINGS AND COST VARIATIONS TO THE ARCHITECT FOR THEIR WRITTEN APPROVAL



CAISSON DESIGN GROUP PTY L TRADING AS ARCHITECTURE CAISSON
SUITE 3 14 WALLACE AVE TOORAK VICTORIA 3142 AUSTRALIA

ABN 56 607 067 925 ACN 607 067 925 PH +61 3 9988 1919

WWW.CAISSON.COM.AU

PROJECT CARINISH ROAD APARTMENTS **ADDRESS** 

179 CARINISH ROAD, CLAYTON VIC DWG TITLE

EXTERNAL WORKS DWG NO. SCALE REVISION 10.05.2018 TP04 TP501 AZ/CB/JW